IREDELL COUNTY HEALTH DEPARTMENT

STATESVILLE 704-878-5305 (2) MOORESVILLE 704-664-5281

(1) IMPROVEMENT PERMIT / AUTHORIZATION TO CONSTRUCT / OPERATION PERMIT / EXISTING SYSTEM INSPECTION

PERMIT# 123830 PIN# 4775-45-2107 DATE 9-10-04

OWNER OR CONTRACTOR JEFFREY TODD ELLIS PHONE: Business 704-902-0119 Home 704-878-6633

ADDRESS 315 SEVEN SPRINGS LOOP, STATESVILLE NC 28625

LOCATION US64 EAST, 2ND DRIVE ON LEFT PAST HUNTERS RIDGE, ~850' BACK OFF ROAD

SUBDIVISION _____ BLOCK / SECTION _____ LOT _____ LOT AREA 7.3792 ACRES SITE CLASS. PS DESIGN FLOW 360 L.T.A.R. 0.25 GPD/FT²

Septic Tank: 1000 Gallons; STB 1012 Date 9-5-04

Pump Tank: _____ Gallons; PT _____ Date _____

Pump Make: _____ Model _____ Serial No. _____

Nitrification Field: No Fields 1 Square Feet 1440 Linear Feet 480

No Lines SIX Trench Width 36" Trench Bottom Depth 36" Gravel Depth 12"

☑ New System ☐ Repair System Type: I, (II), III, IV, V, VI

System Description: CONVENTIONAL, GRAVITY

Repair System Description: CONVENTIONAL, PUMP

Maintenance Agreement Required: ☐ Yes ☑ No

☑ House/Mod. Home No. Bedrooms 3

☐ Mobile Home No. Bathrooms _____

☐ Business No. Employees _____

☐ Other _____


☑ Slab ☐ Crawl Space ☐ Basement w/plumbing ☐ Basement wo/plumbing

Water Supply: ☐ Individual ☑ Public ☐ Community

Comments:/Conditions: INSTALL DRAINLINES AT 36" DEEP ON CONTOUR AS FLAGGED

Comments:/Conditions: SEPTIC TANK WITH MARKER INSTALLED USING "TUFTITE" FILTER

INITIAL SITE SKETCH ~SCALE: 1"=50'

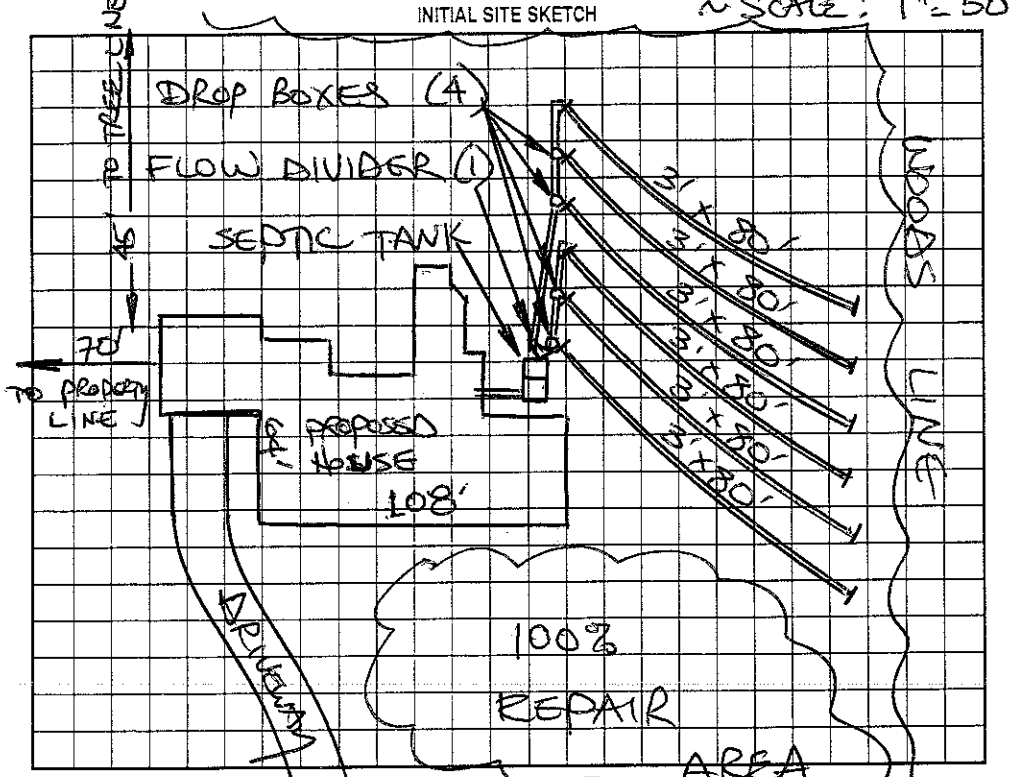

AS BUILT SKETCH

SYSTEM INSTALLED ACCORDING TO INITIAL SITE SKETCH

Permit can be suspended or revoked if any false information is supplied toward securing the permit/any unauthorized changes are made to the site/any unauthorized changes are made in the installation of the system. Improvement Permit with plat valid without expiration. Improvement Permit with site plan valid for sixty months. Authorization to Construct is valid for a period equal to that of Improvement Permit – not to exceed sixty months.

Signed: D. Mark Cox date 9/10/04

Improvement Permit by: STEVE HEDRICK date 9-10-04

Authorization to Construct by: STEVE HEDRICK date 9-10-04

Installed by: DAVID YOUNTZ

Operation Permit by: STEVE HEDRICK date 4-26-05

Existing System Inspection by: _____ date _____

HEALTH DEPT. COPY: WHITE OWNER COPY (FINAL): YELLOW OWNER COPY (INITIAL): PINK