IREDELL COUNTY HEALTH DEPARTMENT

STATESVILLE 704-878-5305 (C) MOORESVILLE 704-664-5281

IMPROVEMENT PERMIT / AUTHORIZATION TO CONSTRUCT / OPERATION PERMIT / EXISTING SYSTEM INSPECTION

PERMIT# 100160 PIN# 4775 45 5129 DATE 9/13/01

OWNER OR CONTRACTOR Sharon Welborn PHONE: Business [redacted] (704) 873-5661 (Ext. 3565) Home (704) 871-0862

ADDRESS 1107 Mocksville Hwy Statesville N.C. 28625

LOCATION Hwy 64 EAST on left past Hunter Ridge off Rock 400 yds below 1107 B-4 BARNYARD RD

SUBDIVISION — BLOCK / SECTION — LOT — LOT AREA +/- 2.0 AC SITE CLASS PS DESIGN FLOW 360 L.T.A.R. .35

Septic Tank: 1,000 Gallons: STB 825 Date 10-25-01
Pump Tank: 1,000 Gallons: PT 302 Date 10-10-01
Pump Make: HYDROMATIC Model SHEF 50M Serial No.
Nitrification Field: No. Fields 1 Square Feet 1029 Linear Feet 344
No. Lines 4@86 Trench Width 36" Max Trench Bottom Depth 30" Gravel Depth 12"

X New System ☐ Repair System Type: I. II. III. IV. V. VI
System Description: Pump, Conventional
Repair System Description: Pump, 25% Repair
Maintenance Agreement Required: ☐ Yes X No

X House/Mod. Home No. Bedrooms 3
☐ Mobile Home No. Bathrooms 2
☐ Business No. Employees
☐ Other
☐ Slab X Crawl Space ☐ Basement w/plumbing ☐ Basement wo/plumbing


Water Supply: X Individual ☐ Public ☐ Community

Comments/Conditions:

Comments/Conditions: (1) DRAW LINES INSPECTED 12-4-01, OK, MUCH CHROMA 2 MOTTLING NOTED, FUTURE REPAIR MAY REQUIRE SUBSURFACE INTERCEPT DRAINAGE DITCH, ROM. 52½ 39½
(2) TANKS AND PRESSURE CHECK COMPLETED 12-5-01, RSH

INITIAL SITE SKETCH

Not to Scale

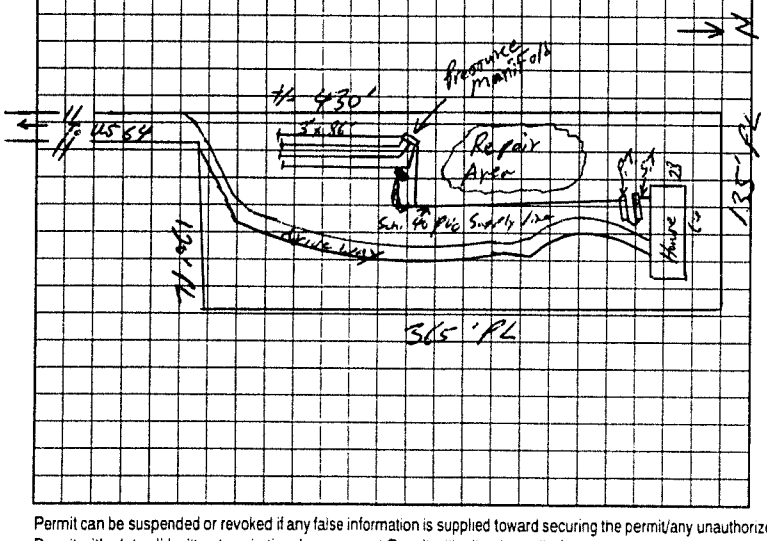

AS BUILT SKETCH

SYSTEM INSTALLED ACCORDING TO INITAL SITE SKETCH

Permit can be suspended or revoked if any false information is supplied toward securing the permit/any unauthorized changes are made to the site/any unauthorized changes are made in the installation of the system. Improvement Permit with plat valid without expiration. Improvement Permit with site plan valid for sixty months. Authorization to Construct is valid for a period equal to that of Improvement Permit – not to exceed sixty months.

Signed: Sharon Welborn date 9-13-01 Installed by: STATESVILLE BACKHOE

Improvement Permit by: William E. Johnson date 9/13/01 Operation Permit by: STEVE HERRICK date 2-19-02

Authorization to Construct by: William E. Johnson date 9/13/01 Existing System Inspection by: date

HEALTH DEPT. COPY: WHITE OWNER COPY (FINAL): YELLOW OWNER COPY (INITIAL): PINK