IREDELL COUNTY HEALTH DEPARTMENT

STATESVILLE 704-878-5305 MOORESVILLE 704-664-5281

IMPROVEMENT PERMIT / AUTHORIZATION TO CONSTRUCT / OPERATION PERMIT / EXISTING SYSTEM INSPECTION

PERMIT# 13717 PIN# 4775462011 DATE 8-18-06

OWNER OR APPLICANT Robert Smith PHONE: Business 704-880-6620 Home

ADDRESS 000 Nottingham Circle Statesville NC 28625

LOCATION Off Sain Rd Fox Creek Rd Nottingham Lot on #7

SUBDIVISION Fox Creek BLOCK / SECTION LOT 7 LOT AREA 1.237 SITE CLASS. DESIGN FLOW 450 L.T.A.R. .25

Septic Tank: 1500 Gallons; STB 1017 Date 9-26-06
Pump Tank: Gallons; PT Date
Pump Make: Model Serial No.
Nitrification Field: No Fields Square Feet 1920 Linear Feet 450
No Lines 5 Trench Width 36 Max Trench Bottom Depth 36

☐ New System ☐ Repair ☐ Expansion System Type: I II III IV V VI
System Description: 25% Grade
Repair System Description: Low Pressure Pipe
Maintenance Agreement Required: ☐ Yes ☐ No
Gravel Depth ☐ Gravity ☐ Pressure

☑ House/Mod. Home No. Bedrooms 4
☐ Mobile Home No. Persons
☐ Business No. Employees
☐ Other


Water Supply: ☐ Individual ☑ Public ☐ Community

☐ Slab ☐ Crawl Space ☐ Basement w/plumbing ☐ Basement wo/plumbing


Comments:/Conditions:
Call health department for layout after clearing

Comments:/Conditions:
Install on contour
Maintain all setbacks
Yellow tuff tape
Septic tank marker

INITIAL SITE SKETCH

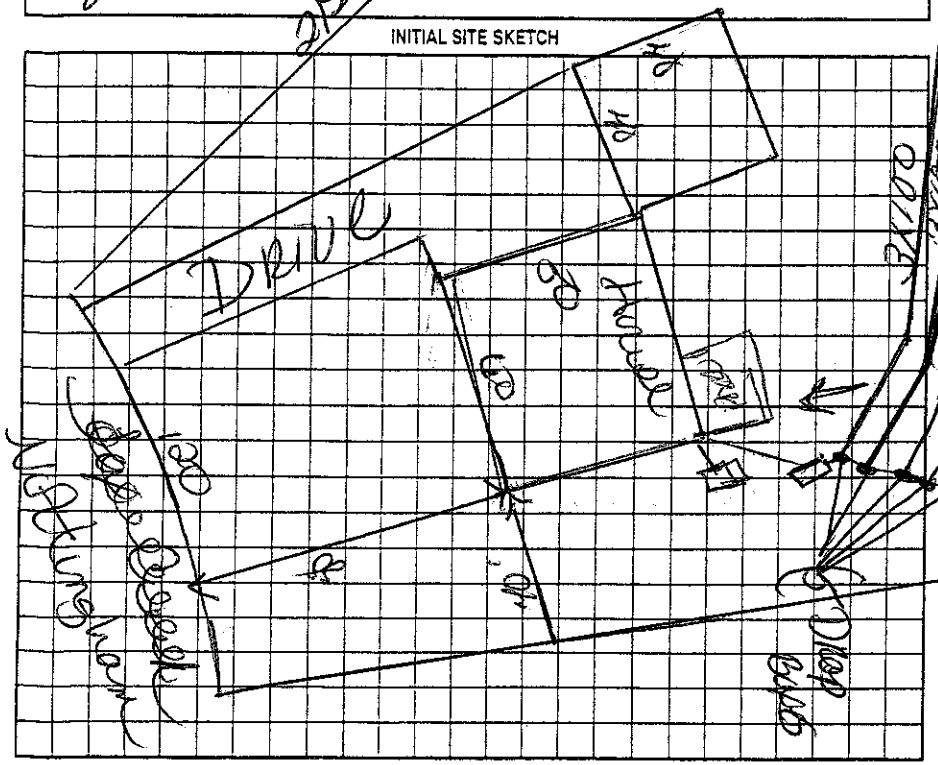

AS BUILT SKETCH

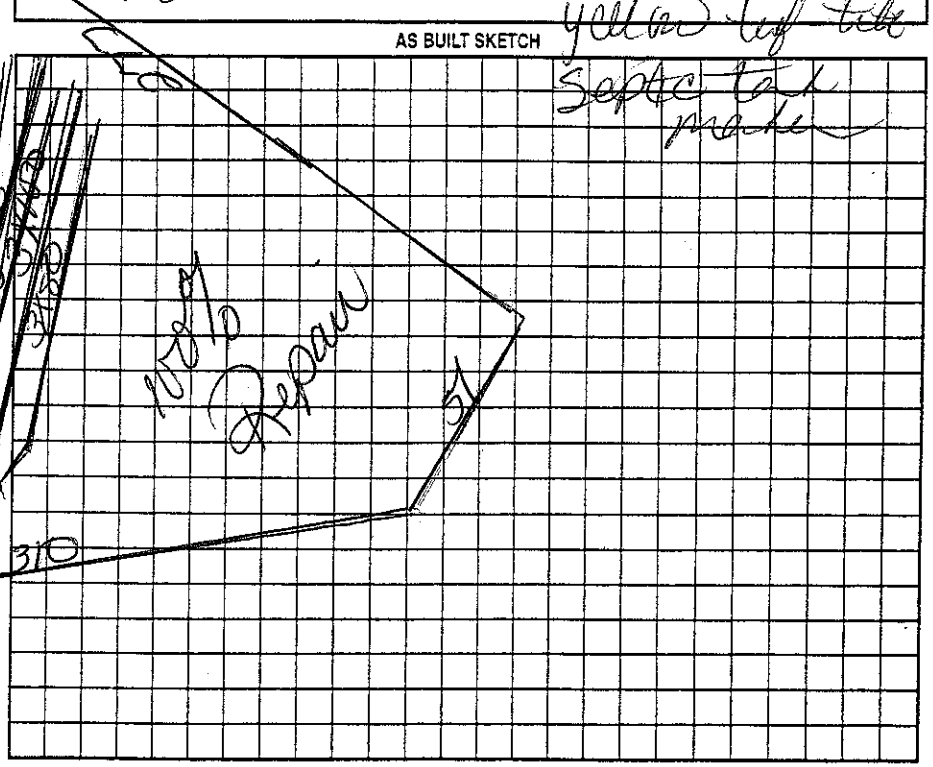

Permit can be suspended or revoked if any false information is supplied toward securing the permit/any unauthorized changes are made to the site/any unauthorized changes are made in the installation of the system. Improvement Permit with plat valid without expiration. ☐ Improvement Permit with site plan valid for sixty months ☐ Authorization to Construct is valid for a period equal to that of Improvement Permit – not to exceed sixty months.

Signed: Matt Mooney date

Installed by: Steve Yoder

Improvement Permit by: Kelly Cox date 3-18-06

Operation/Permit by: Kelly Cox date 4-26-07

Authorization to Construct by: Kelly Cox date 8-18-06

Existing System Inspection by: date

HEALTH DEPT. COPY: WHITE OWNER COPY (FINAL): YELLOW OWNER COPY (INITIAL): PINK