IREDELL COUNTY HEALTH DEPARTMENT

STATESVILLE 704-878-5305 MOORESVILLE 704-664-5281

IMPROVEMENT PERMIT / AUTHORIZATION TO CONSTRUCT / OPERATION PERMIT / EXISTING SYSTEM INSPECTION

PERMIT # REPAIR PIN # 4775-46-2669 DATE July 28, 2009

OWNER or APPLICANT JEFFREY H. BADGETT PHONE: Business 386-251-9787 Home: 704-881-0787

OWNER or APPLICANT ADDRESS 201 NOTTINGHAM CIRCLE, STATESVILLE, NC 28677-8201

LOCATION / DIRECTIONS US 64 EAST, TL SAIN ROAD, TR FOX CREEK S/D, LOT ON BACK SIDE of NOTTINGHAM CIR.


SUBDIVISION FOX CREEK BLOCK / SECTION LOT # 10 LOT AREA DESIGN FLOW 480 L.T.A.R. EXISTING

Septic Tank	1000 Gallons: STB 760	Date 5-9-09	☐ New System ☑ Repair ☐ Expansion System Type I (II) III IV V VI	☑ Residence	No. Bedrooms 4	Water Supply
Pump Tank	Gallons: P T	Date	System Description:	☐ Business	No. Persons	☐ Private
Pump Make	Model	Serial #	Repair System Description: CONVENTIONAL, GRAVITY	☐ Other	No. Employees	☑ Public
Nitrification Field	No Fields 1 No Lines 1 Linear Feet EXISTING		Maintenance Agreement Required ☐ YES ☑ NO	☐ Slab	☑ Crawl Space	☐ Community
Trench Width EX	Max. Trench Bottom Depth EX	Gravel Depth EX	☑ GRAVITY ☐ PRESSURE	☐ Basement w/plumbing	☐ Basement w/o plumbing	

Comments / Conditions: ABANDON EXISTING SEPTIC TANK & CRUSH & FILL WITH CLAY SOIL. INSTALL NEW SEPTIC TANK AT LOCATION SHOWN. SYSTEM UNDERSIZED ACCORDING TO TODAY'S STANDARDS

Comments / Conditions: POLYLOK F. Her ~~MARKER~~ RISERS. OLD 4" Corrugated pipe cut & new 3" PVC from NEW TANK INSTALLED TO IT. INSTALLED AS DRAWN.

INITIAL SITE SKETCH

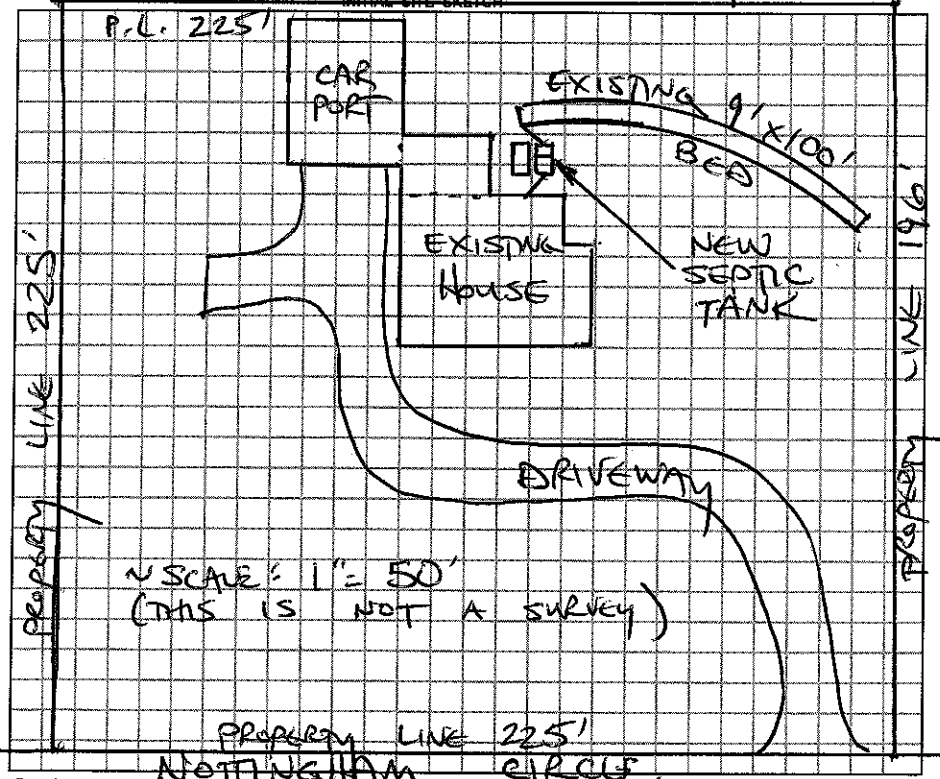

AS BUILT SKETCH

Permit can be suspended or revoked if any false information is supplied toward securing the permit / any unauthorized changes are made to the site / any unauthorized changes are made in the installation of the system.

☐ *IMPROVEMENT PERMIT w / plat valid without expiration.* ☐ *IMPROVEMENT PERMIT w / site plan valid for 60 mos.* ☐ *AUTHORIZATION TO CONSTRUCT valid for period equal to IMPROVEMENT PERMIT-not to exceed 60 mo.*

Owner / Applicant Signature: [signature] Date 7/28/09

Improvement Permit by: STEVE HEDRICK Date 7-28-09

Authorzation to Construct by: STEVE HEDRICK Date 7-28-09

Installed by: LENTZ WASTEWATER MGMT

Operation Permit by: [signature] Date: 7/30/09

Existing System Inspected by: Date:

YOU SHOULD CONTACT A LOCATOR SERVICE PRIOR TO ANY EXCAVATION.

WHITE COPY Environmental Health YELLOW COPY (Final) Owner / Applicant PINK COPY (Initial) Owner / Applicant