IREDELL COUNTY HEALTH DEPARTMENT

STATESVILLE 704-878-5305 MOORESVILLE 704-664-5281

IMPROVEMENT PERMIT / AUTHORIZATION TO CONSTRUCT / OPERATION PERMIT / EXISTING SYSTEM INSPECTION

CI

PERMIT# 77710 PIN# 4775474615 DATE 11-16-98

OWNER OR CONTRACTOR ~~John Barber~~ Michele Hambright PHONE: Business 938 0908 Home

ADDRESS 132 Sweet Gum Lane Sta. N.C.

LOCATION 64E TL Sain Rd TR ~~Nottingham~~ Foxcreek TL Nottingham Circle on rt

SUBDIVISION Foxcreek BLOCK / SECTION LOT 14 LOT AREA 2.76 acres SITE CLASS. PS DESIGN FLOW 360 L.T.A.R. .13

Septic Tank: 1000 Gallons; STB 825 Date 1-5-03

Pump Tank: Gallons; PT Date

Pump Make: Model Serial No.

Nitrification Field: No Fields 1 Square Feet 1200 Linear Feet 400

No Lines 4 Trench Width 36" Max Trench Bottom Depth 36" Gravel Depth 12"

☑ New System ☐ Repair System Type: I, II, III, IV, V, VI

System Description: Conv. Gravity

Repair System Description: " "

Maintenance Agreement Required: ☐ Yes ☐ No

☑ House/Mod. Home No. Bedrooms 3

☐ Mobile Home No. Bathrooms 2

☐ Business No. Employees

☐ Other


☐ Slab ☑ Crawl Space ☑ Basement w/plumbing ☐ Basement wo/plumbing

Water Supply: ☐ Individual ☐ Public ☐ Community


Comments:/Conditions: (1) LL REVIEWED PLANS FOR A 35'x40' HOUSE. PLANS ATTACHED. APPROVED. CHANGED FROM A BASEMENT TO CRAWL SPACE

Comments:/Conditions: 335' POLYLOK FILTER & MARKER INSTALLED AS SHOWN

INITIAL SITE SKETCH

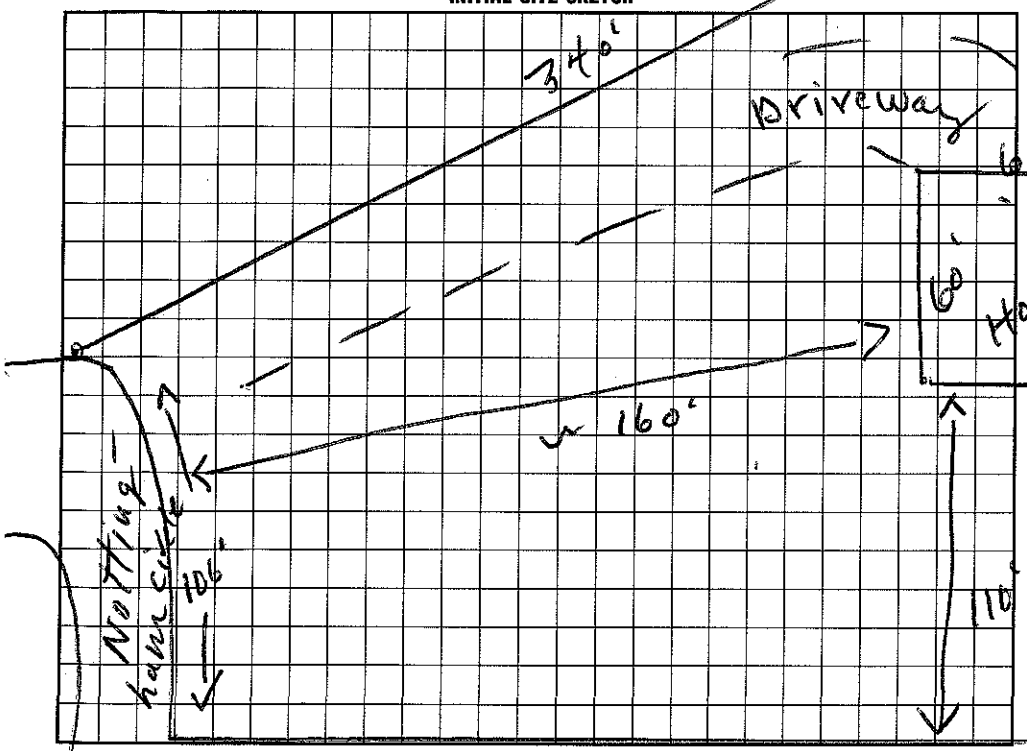

AS BUILT SKETCH

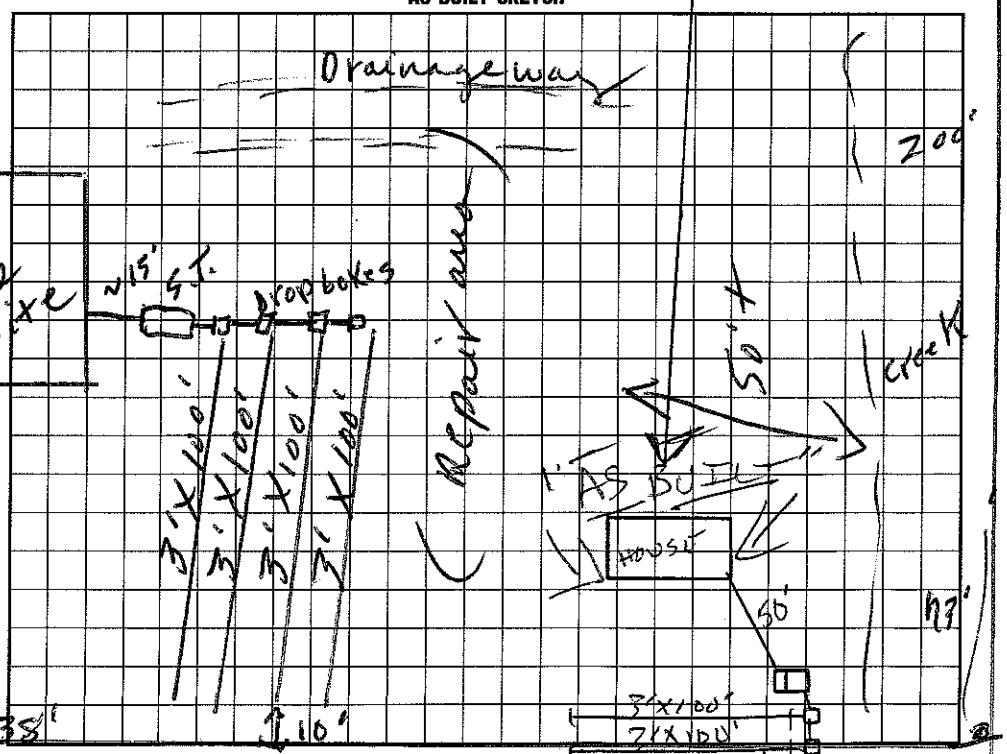

I understand that this permit can be suspended or revoked if any false information is supplied toward securing the permit/any unauthorized changes are made to the site/any unauthorized changes are made in the installation of the system. Improvement Permit with plat valid without expiration. Improvement Permit with site plan valid for sixty months. Authorization to Construct is valid for a period equal to that of Improvement Permit – not to exceed sixty months.

Will expire 11-16-03

Signed: ✕ John W. Barber date

Installed by: ROWAN SEPTIC

Improvement Permit by: R.C. Moore date 11-16-98

Operation Permit by: [illegible] date 03-11-03

Authorization to Construct by: R.C. Moore date 11-16-98

Existing System Inspection by: date

REPAIR BELOW

HEALTH DEPT. COPY: WHITE INSPECTION COPY (FINAL): GREEN OWNER COPY (FINAL): YELLOW INSPECTION COPY (INITIAL): PINK OWNER COPY (INITIAL): GOLD