IREDELL COUNTY HEALTH DEPARTMENT

STATESVILLE 704-878-5305 MOORESVILLE 704-664-5281

IMPROVEMENT PERMIT / CERTIFICATE OF COMPLETION / OPERATION PERMIT / EXISTING SYSTEM INSPECTION

PROPERTY DESCRIPTION NO. _____ DATE 3-29-96 TAX MAP NO. _____ Watershed: ☐ Yes ☐ No

OWNER OR CONTRACTOR Richard B Jenkins Jr. PHONE: Business _____ Home 873-4557

ADDRESS 1176 Mocksville Hwy. sta.

LOCATION 64E past Barry Oak Rd 1/4 mi RT

SUBDIVISION _____ BLOCK / SECTION _____ LOT _____ LOT AREA 5 acres SITE CLASS. PE DESIGN FLOW 760 L.T.A.R. 1.35

Septic Tank: 1000 Gallons; STB 794 Date 2-26-96

Pump Tank: _____ Gallons; PT _____ Date _____

Pump Make: _____ Model _____ Serial No. _____

Nitrification Field: No Fields ____ Square Feet _____ Linear Feet _____

No Lines _____ Trench Width _____ Max Trench Bottom Depth _____ Gravel Depth _____

☐ New System ☑ Repair System Type: I, II, (III) IV, V, VI

System Description: _____

Repair System Description: Gravity/Chambers

Maintenance Agreement Required: ☐ Yes ☑ No

☑ House/Mod. Home No. Bedrooms 3

☐ Mobile Home No. Bathrooms 2

☐ Business No. Employees ____

☐ Other _____


☐ Slab ☐ Crawl Space ☐ Basement w/plumbing ☑ Basement wo/plumbing

Water Supply: ☐ Individual ☐ Community ☐ Public

Comments: Replacing EX S.T. System
Replumb to New S.T.

Comments:

INITIAL SITE SKETCH

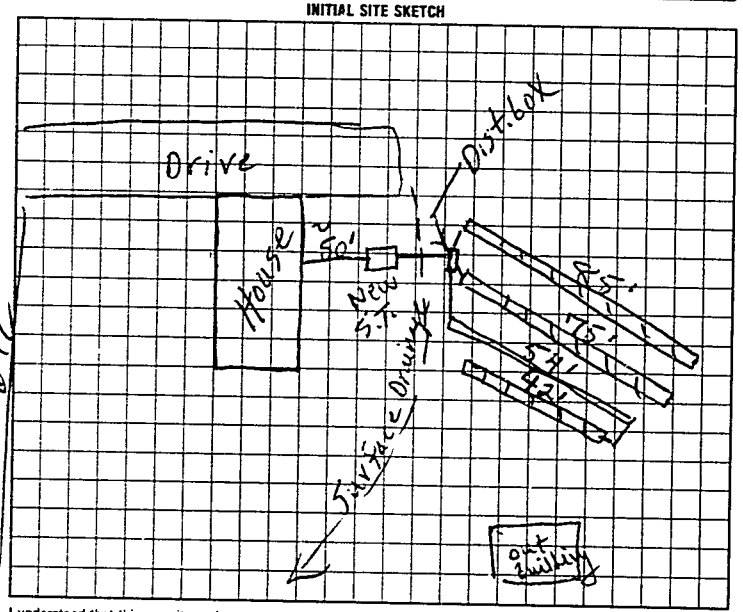

AS BUILT SKETCH

SYSTEM INSTALLED ACCORDING TO INITIAL SITE SKETCH

I understand that this permit can be suspended or revoked if any false information is supplied toward securing the permit/any unauthorized changes are made to the site/any unauthorized changes are made in the installation of the system. Improvement Permit is valid for 60 months from date of issuance.

Signed: x Richard B Jenkins Jr

Improvement Permit by: L.C. Moore date 3-29-96

Existing System Inspection by: authorization to contractor L.C. Moore date 3-29-96

Installed by: A-1 BACKHOE

Certificate of Completion by: _____ date _____

Operation Permit by: STEVE HEDRICK date 4-8-96

HEALTH DEPT COPY WHITE — INSPECTION COPY (FINAL) GREEN — OWNER COPY (FINAL) YELLOW — INSPECTION COPY (INITIAL) PINK — OWNER COPY (INITIAL) GOLD