IREDELL COUNTY HEALTH DEPARTMENT

STATESVILLE 704-878-5305 MOORESVILLE 704-664-5281

IMPROVEMENT PERMIT / CERTIFICATE OF COMPLETION / OPERATION PERMIT / EXISTING SYSTEM INSPECTION

PROPERTY DESCRIPTION NO. 67162 DATE 6-17-97 TAX MAP NO. ~~6776~~ 4775 71 0637 Watershed: ☐ Yes ☐ No

OWNER OR CONTRACTOR George moore PHONE: Business _____ Home 872-7821

ADDRESS 1135 Fourth Creek Lanting Sta.

LOCATION 64E TR Barrycck Rd TR mills Garden Rd 1st lot Rt.

SUBDIVISION _____ BLOCK / SECTION _____ LOT _____ LOT AREA 1.67acres SITE CLASS. PS DESIGN FLOW 360 L.T.A.R. .3

Septic Tank: ~~Existing~~ 1000 Gallons; STB 1007 Date 7-24-97

Pump Tank: _____ Gallons; PT _____ Date _____

Pump Make: _____ Model _____ Serial No. _____

Nitrification Field: No Fields 1 Square Feet 1200 Linear Feet 400

No Lines 3 Trench Width 36" Max Trench Bottom Depth 36" Gravel Depth 12"

☐ New System ☐ Repair System Type: I, II, III, IV, V, VI

System Description: Conv. Gravity

Repair System Description: " "

Maintenance Agreement Required: ☐ Yes ☐ No

☐ House/Mod. Home No. Bedrooms 3

☐ Mobile Home No. Bathrooms 2

☐ Business No. Employees _____

☐ Other _____


☐ Slab ☐ Crawl Space ☐ Basement w/plumbing ☐ Basement wo/plumbing

Water Supply: ☒ Individual ☐ Community ☐ Public


Comments:

Comments: New Septic will be set old Tank ~~found~~ not suitable Jcm 8-1-97

INITIAL SITE SKETCH

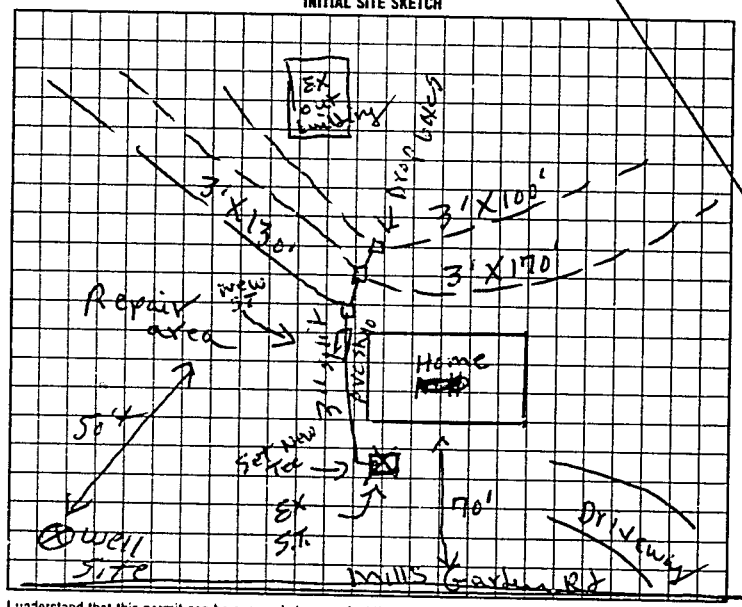

AS BUILT SKETCH

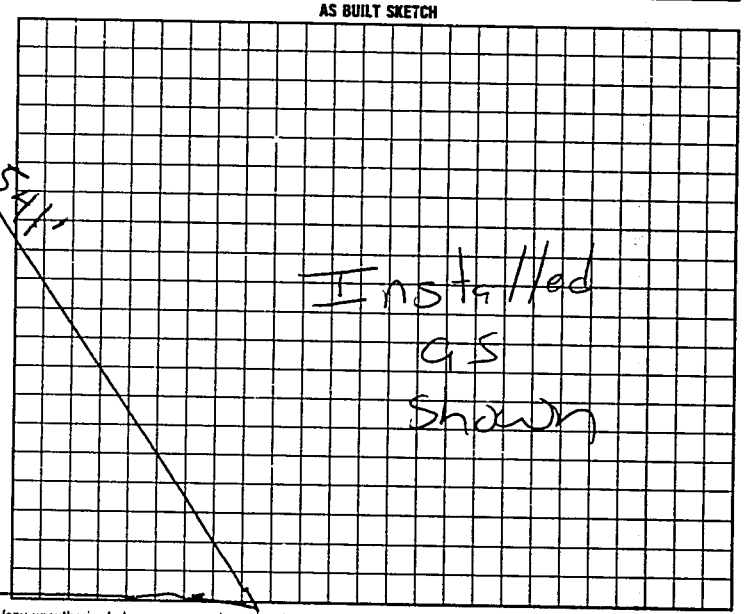

I understand that this permit can be suspended or revoked if any false information is supplied toward securing the permit/any unauthorized changes are made to the site/any unauthorized changes are made in the installation of the system. Improvement Permit is valid for 60 months from date of issuance.

Signed: X _____

Improvement Permit by: J.C. moore date 6-17-97

~~Existing System Inspection~~ Authorization by: J.C. moore date 6-17-97

To cont.

Installed by: Berry Sigmon

Certificate of Completion by: _____ date _____

Operation Permit by: Mary C Cox date 9-4-97

HEALTH DEPT. COPY: WHITE INSPECTION COPY (FINAL): GREEN OWNER COPY (FINAL): YELLOW INSPECTION COPY (INITIAL): PINK OWNER COPY (INITIAL): GOLD

Authorization to Const. Expires 60 mos from issue

9 7 6 7 0 0