@ 125.00 pd. VHD

# IREDELL COUNTY HEALTH DEPARTMENT

STATESVILLE 704-878-5305 MOORESVILLE 704-664-5281

## IMPROVEMENT PERMIT / AUTHORIZATION TO CONSTRUCT / OPERATION PERMIT / EXISTING SYSTEM INSPECTION

PERMIT# 094/99 PIN# 4775 80 8293 DATE 02/20/01

OWNER OR CONTRACTOR MICHAEL VALENTINE PHONE: Business 828-586-1201 Home

ADDRESS 256 MAGGIE LANE, WHITTIER, NC 28789

LOCATION 646, @ BARRY OAK, @ MILLS GAP, 3/10 MI on LEFT

SUBDIVISION BLOCK / SECTION LOT LOT AREA 15.00 ACRES SITE CLASS IS DESIGN FLOW 360 L.T.A.R. .25

Septic Tank: 1000 Gallons: STB 825 Date 2-15-01
Pump Tank: Gallons: PT Date
Pump Make: Model Serial No.
Nitrification Field: No Fields 1 Square Feet EQ=RR10 Linear Feet 360'
No Lines 6 Trench Width 36" Max Trench Bottom Depth 24" Gravel Depth N/A


X New System ☐ Repair System Type: I. II. III. IV. V. VI
System Description: 25% REDUCTION
Repair System Description: PUMP 25% REDUCTION
Maintenance Agreement Required: ☐ Yes X No

X House/Mod. Home ☐ Mobile Home ☐ Business ☐ Other
No. Bedrooms 3 No. Bathrooms 2½ No. Employees
☐ Slab ☐ Crawl Space X Basement w/plumbing ☐ Basement wo/plumbing

Water Supply: X Individual ☐ Public ☐ Community

Comments/Conditions: ① KEEP WELL 100' FROM SYSTEM ② USE FLOW DIVIDER TEE AND 4 DROP BOXES ③ KEEP SYSTEM 15' OFF DITCH & ATLEAST 15' FROM BASEMENT FOUNDATION. ④ KEEP TANK 25' AWAY FROM FOUNDATION. ⑤ FOUNDATION DRAIN ⑥ INSTALL LINES ON Contour ⑦ IF BASEMENT HAS PLUMBING USE GRINDER PUMP to clock effluent ⑧ USE 4 FRENCH DRAIN AROUND THE SYSTEM & MAINTAIN 10' ABOVE SYSTEM & SIDES OF SYSTEM.


INITIAL SITE SKETCH "NOT TO SCALE"

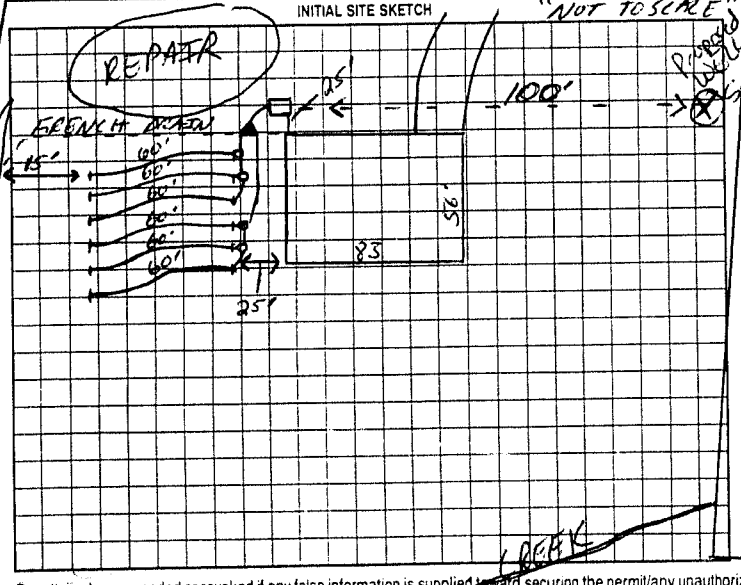


AS BUILT SKETCH

④ CHANGED TO 8 LINES 45' LONG & FLAGGED OUT COMPLETELY FOR INSTALLER. CC 02-25-01

CHECKED LINES & TANK. NEED TO CHECK FRENCH DRAIN, SURFACE DIVERSION, & SAND IN TRENCHES. 4942 - EVERYTHING CHECKED OK. CC

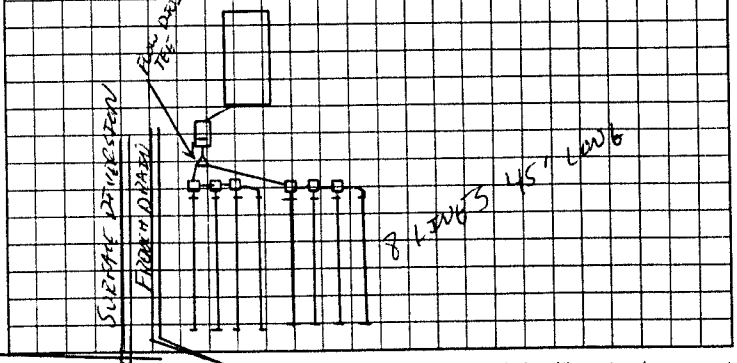


Permit can be suspended or revoked if any false information is supplied toward securing the permit/any unauthorized changes are made to the site/any unauthorized changes are made in the installation of the system. Improvement Permit with plat valid without expiration. Improvement Permit with site plan valid for sixty months. Authorization to Construct is valid for a period equal to that of Improvement Permit – not to exceed sixty months.

Signed: Mrs. Jewel Valentine date

Improvement Permit by: Jim Cook RS I date 02/20/01

Authorization to Construct by: Jim Cook RS I date 02/24/01

Installed by: MATT MULLATT

Operation Permit by: Jim Cook RS date 04-09-02

Existing System Inspection by: date

HEALTH DEPT COPY WHITE OWNER COPY (FINAL) YELLOW OWNER COPY (INITIAL) PINK