IREDELL COUNTY HEALTH DEPARTMENT

STATESVILLE 704-878-5305 MOORESVILLE 704-664-5281

IMPROVEMENT PERMIT / AUTHORIZATION TO CONSTRUCT / OPERATION PERMIT / EXISTING SYSTEM INSPECTION

PERMIT# 71449 + 80853 PIN# 4775909155 DATE 2-23-98

OWNER OR CONTRACTOR Aaron Jones PHONE: Business Home 872 5894

ADDRESS Elmwood Rd

LOCATION 64E TR Barry oak TR Elmwood 1/2 mi Rt

SUBDIVISION BLOCK / SECTION LOT LOT AREA 1 acre SITE CLASS PS DESIGN FLOW 360 L.T.A.R. .24

Septic Tank: 1000 Gallons; STB 794 Date 11-13-98
Pump Tank: Gallons; PT Date
Pump Make: Model Serial No.
Nitrification Field: No Fields 1 Square Feet 1500 Linear Feet 500
No Lines 5 Trench Width 36" Max Trench Bottom Depth 24" Gravel Depth 12"

☑ New System ☐ Repair System Type: I (II) III, IV, V, VI
System Description: Conv. Gravity
Repair System Description: Gravity Chambers
Maintenance Agreement Required: ☐ Yes ☑ No
☐ Slab ☑ Crawl Space ☐ Basement w/plumbing ☐ Basement wo/plumbing


☑ House/Mod. Home No. Bedrooms 3
☐ Mobile Home No. Bathrooms 2
☐ Business No. Employees
☐ Other

Water Supply: ☑ Individual ☐ Public ☐ Community


Comments/Conditions:

Comments/Conditions:
No well - Now have County water
Extra footage added to lines

INITIAL SITE SKETCH 300'

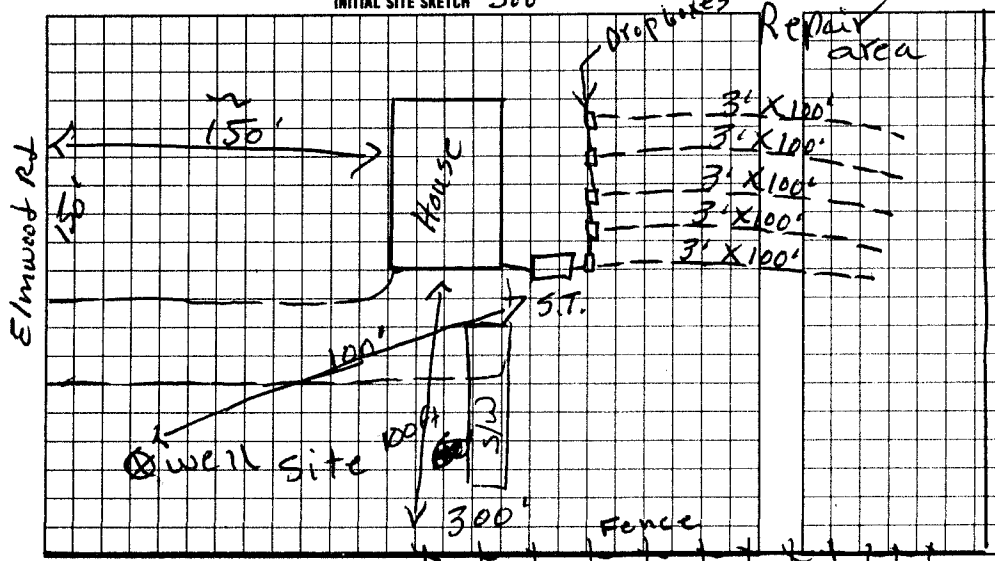

AS BUILT SKETCH

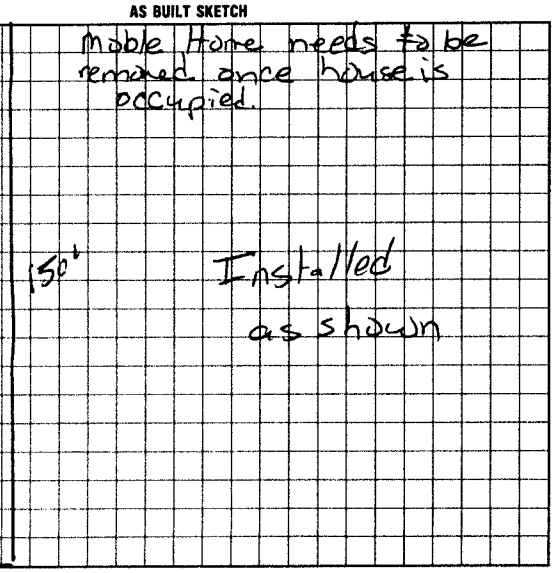

I understand that this permit can be suspended or revoked if any false information is supplied toward securing the permit/any unauthorized changes are made to the site/any unauthorized changes are made in the installation of the system. Improvement Permit with plat valid without expiration. Improvement Permit with site plan valid for sixty months. Authorization to Construct is valid for a period equal to that of Improvement Permit – not to exceed sixty months.

Signed: Aaron W Jones date

Improvement Permit by: R. C. Moore date 2-23-98

Authorization to Construct by: R. C. Moore date 2-23-98

Installed by: Wes Lytton

Operation Permit by: Mary Catherine Ross date 6-2-99

Existing System Inspection by: date

HEALTH DEPT. COPY WHITE INSPECTION COPY (FINAL) GREEN OWNER COPY (FINAL) YELLOW INSPECTION COPY (INITIAL) PINK OWNER COPY (INITIAL) GOLD