IREDELL COUNTY HEALTH DEPARTMENT

Statesville Office (704) 878-5305 Mooresville Office (704) 660-3625

IMPROVEMENT PERMIT / AUTHORIZATION TO CONSTRUCT / OPERATION PERMIT / EXISTING SYSTEM

PERMIT # 214059

PIN # 4775909851

APPLICANT: Gary Conley

APPLICANT ADDRESS: 170 Elmwood Rd.

SITE ADDRESS: 170 Elmwood Rd.

PHONE: 704-929-2997 ALT. PHONE: N/A

SITE DIRECTIONS: Hwy 64 E TR Burr Oak TR Elmwood Rd. Property on Right

SUBDIVISION: N/A

SECTION: N/A LOT # N/A LOT AREA: 1.63acres DESIGN FLOW: 360gpd L.T.A.R.: Existing

Septic Tank	Existing (gal)	STB	Date		
Pump Tank	(gal)	PT	Date		
Pump Make	Model		Serial #		
# Nitrification Fields	Ex # Lines	Ex	Linear Ft:	Ex	
Trench Width	Ex Max. Trench Bottom Depth	Ex	Gravel Depth	Ex	

☐ New System ☐ Repair ☐ Expansion System Type: I II (III) IV V VI

System Description: Existing

Repair System Description:

Maintenance Agreement Required: ☐ YES ☑ NO ☐ GRAVITY ☐ PRESSURE


☑ Residence No. Bedrooms 3
☐ Business No. Persons 6
☐ Other No. Employees
☐ Slab ☑ Crawl Space
☐ Basement w/plumbing ☐ Basement w/o plumbing

Water Supply: ☐ Private ☑ Public ☐ Community


Comments / Conditions:

Maintain a minimum of 5' between any building foundation & all components of septic tank system & repair area.

INITIAL SITE SKETCH

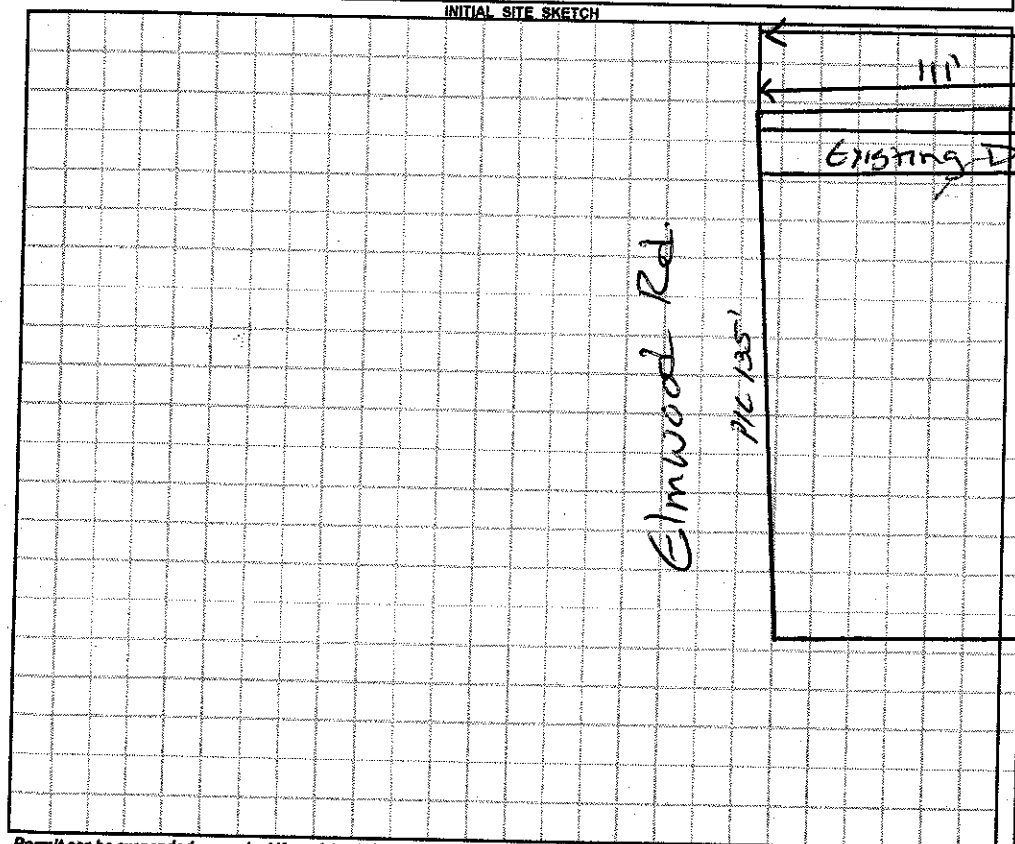

AS BUILT SKETCH

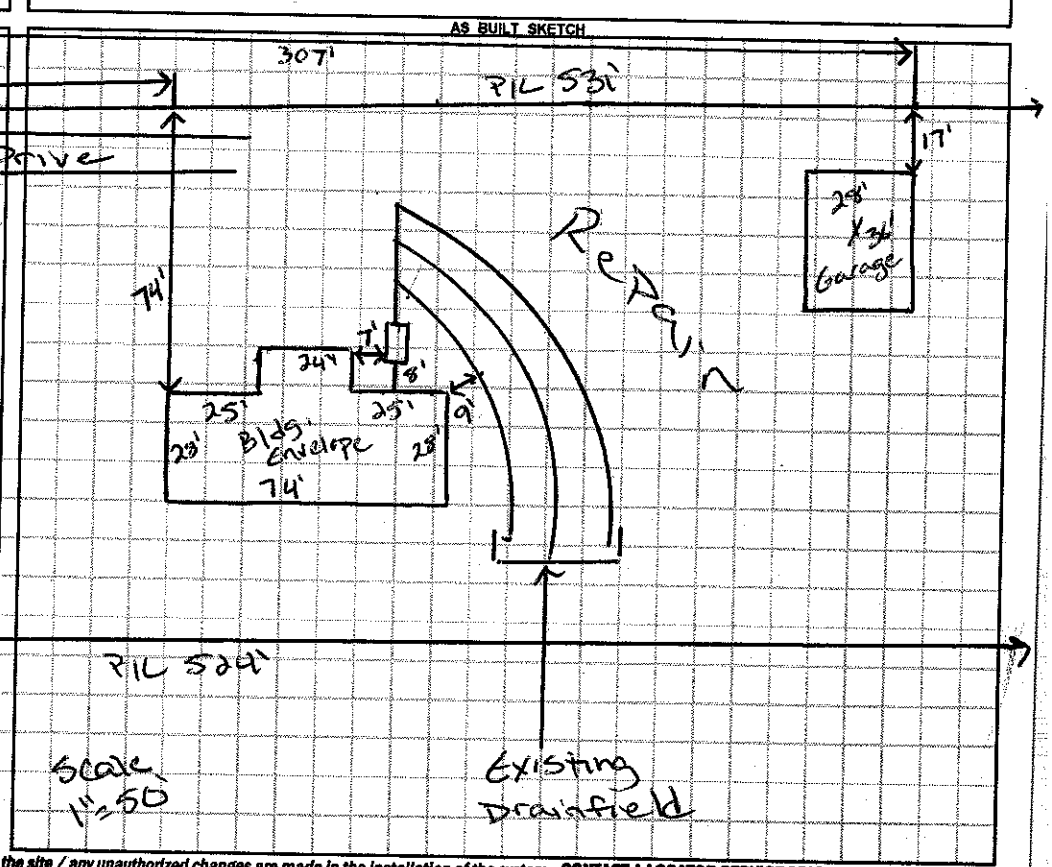

Permit can be suspended or revoked if any false information is supplied toward securing the permit / any unauthorized changes are made to the site / any unauthorized changes are made in the installation of the system. **CONTACT A LOCATOR SERVICE PRIOR TO ANY EXCAVATION**

☐ **IMPROVEMENT PERMIT** *with plat* valid without expiration. ☐ **IMPROVEMENT PERMIT** *with site plan* valid for 60 mos. ☐ **AUTHORIZATION TO CONSTRUCT** valid for period equal to IMPROVEMENT PERMIT--not to exceed 60 mo.

Owner / Applicant Signature: Gary Dean Conley Date: 10-22-2015 Installed by:

IMPROVEMENT PERMIT by: Date:

OPERATION PERMIT by: Date:

AUTHORIZATION TO CONSTRUCT by: Date:

Existing System Inspected by: Justin Henderson Date: 10-22-15

Health Dept. Copy - WHITE Applicant (Final Approval) - YELLOW Applicant (Conditional Approval) - PINK