IREDELL COUNTY HEALTH DEPARTMENT

Statesville Office (704) 878-5305 Mooresville Office (704) 660-3625 PERMIT # 180390

IMPROVEMENT PERMIT / AUTHORIZATION TO CONSTRUCT / OPERATION PERMIT / EXISTING SYSTEM

PIN # 4775909851

APPLICANT: Mary Simmons APPLICANT ADDRESS: 113 Quail Hollow Dr.

SITE ADDRESS: 170 Elmwood Rd. PHONE: 704-902-5407 ALT. PHONE: N/A


SITE DIRECTIONS: Hwy 64E TR Barry Oak Rd TR Elmwood Rd.

SUBDIVISION: N/A SECTION: N/A LOT # N/A LOT AREA: 1.63 acres DESIGN FLOW: 360gpd. L.T.A.R.: 0.3

Septic Tank	1000 (gal)	STB	760-1000	Date	6-23	☑ New System	☐ Repair	☐ Expansion	System Type: I II ☒ III IV V VI	☑ Residence	No. Bedrooms 3	Water Supply
Pump Tank	(gal)	PT		Date		System Description:	25% Reduction			☐ Business	No. Persons	☑ Private
Pump Make		Model		Serial #		Repair System Description:	25% Reduction			☐ Other	No. Employees	☐ Public
# Nitrification Fields	1	# Lines	3	Linear Ft:	300	Maintenance Agreement Required:	☐ YES	☑ NO		☐ Slab	☑ Crawl Space	☐ Community
Trench Width	36"	Max. Trench Bottom Depth	36"	Gravel Depth	N/A	☑ GRAVITY	☐ PRESSURE			☐ Basement w/plumbing	☐ Basement w/o plumbing	

Comments / Conditions: Install a 25% Reduction system on contour with serial distribution.

INITIAL SITE SKETCH

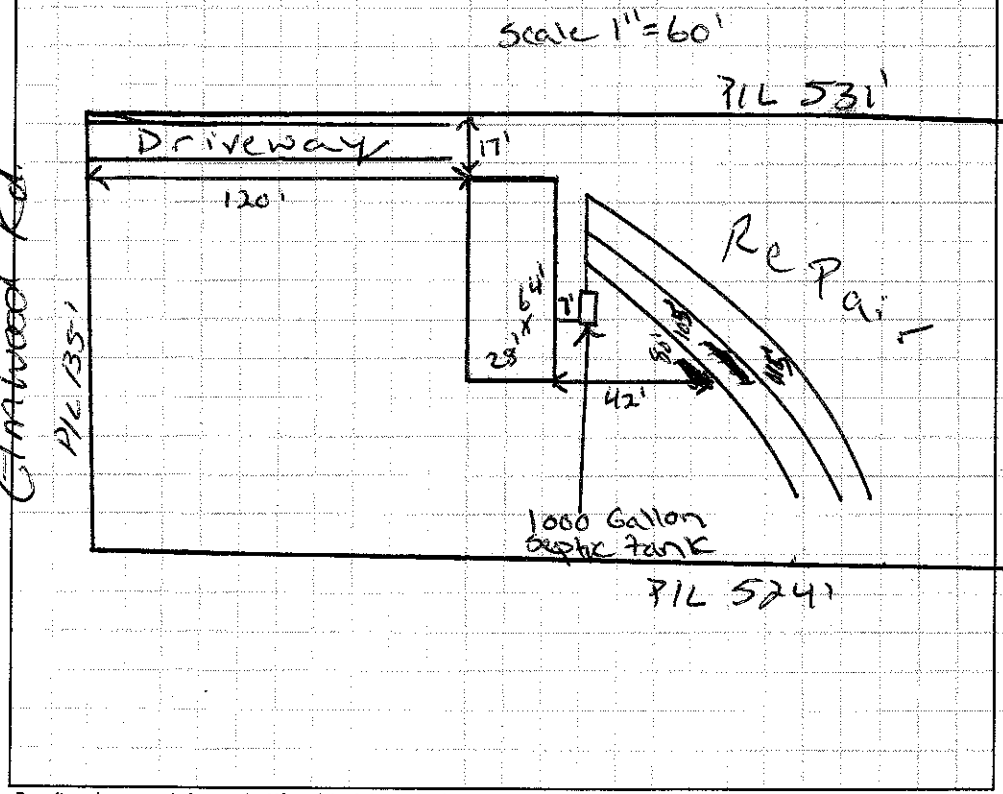

AS BUILT SKETCH

- Red Polylok filter installed
- ARC36 Chambers installed
- Installed as drawn.
- House not set at time of system installation

Permit can be suspended or revoked if any false information is supplied toward securing the permit / any unauthorized changes are made to the site / any unauthorized changes are made in the installation of the system. **CONTACT A LOCATOR SERVICE PRIOR TO ANY EXCAVATION**

☐ **IMPROVEMENT PERMIT** *with plat valid without expiration.* ☑ **IMPROVEMENT PERMIT** *with site plan valid for 60 mos.* ☑ **AUTHORIZATION TO CONSTRUCT** *valid for period equal to IMPROVEMENT PERMIT--not to exceed 60 mo.*

Owner / Applicant Signature: Deena Abee Date: 9/25/13 Installed by: Tim Abee

IMPROVEMENT PERMIT by: Justin Henderson Date: 9-24-13 OPERATION PERMIT by: Justin Henderson Date: 11-21-13

AUTHORIZATION TO CONSTRUCT by: Justin Henderson Date: 9-24-13 Existing System Inspected by: Date:

Health Dept. Copy - WHITE Applicant (Final Approval) - YELLOW Applicant (Conditional Approval) - PINK