IREDELL COUNTY HEALTH DEPARTMENT

STATESVILLE 704-878-5305 MOORESVILLE 704-664-5281

IMPROVEMENT PERMIT / AUTHORIZATION TO CONSTRUCT / OPERATION PERMIT / EXISTING SYSTEM INSPECTION

PERMIT# 093619 PIN# 4775 91 8492 DATE 1-3-01

OWNER OR CONTRACTOR CRAIG DEAL PHONE: Business Home 873-3421

ADDRESS 119 ELMWOOD ROAD STATESVILLE, NC 28625

LOCATION US 64 E TR BARRY OAK RD, TR ELMWOOD RD, 0.1 MILE ON RIGHT

SUBDIVISION CRAIG DEAL BLOCK / SECTION LOT 1 LOT AREA SITE CLASS PS DESIGN FLOW 240 L.T.A.R. 0.20 GPD/FT²

Septic Tank: 1000 Gallons; STB TEC Date 10-6-00
Pump Tank: Gallons; PT Date
Pump Make: Model Serial No
Nitrification Field: No Fields 1 Square Feet 1200 Linear Feet 400
No Lines 31X Trench Width 36" Max Trench Bottom Depth 36" Gravel Depth 12"

☑ New System ☐ Repair System Type: I (II) III IV V VI
System Description: CONVENTIONAL GRAVITY
Repair System Description: CONVENTIONAL GRAVITY
Maintenance Agreement Required: ☐ Yes ☑ No


☑ House/Mod. Home No. Bedrooms 2
☐ Mobile Home No. Bathrooms 1 1/2
☐ Business No. Employees
☐ Other
☐ Slab ☑ Crawl Space ☐ Basement w/plumbing ☐ Basement wo/plumbing

Water Supply: ☐ Individual ☑ Public ☐ Community


Comments/Conditions: USE ONE FLOW DIVIDER TEE TO ACHIEVE EQUAL DISTRIBUTION INTO TWO DISTRIBUTION BOXES FEEDING THREE LINES EACH

Comments/Conditions: ZABELL FILTER INSTALLED
USED SPEED LEVELERS IN BOX #2
SEPTIC TANK WITH MARKER INSTALLED

INITIAL SITE SKETCH

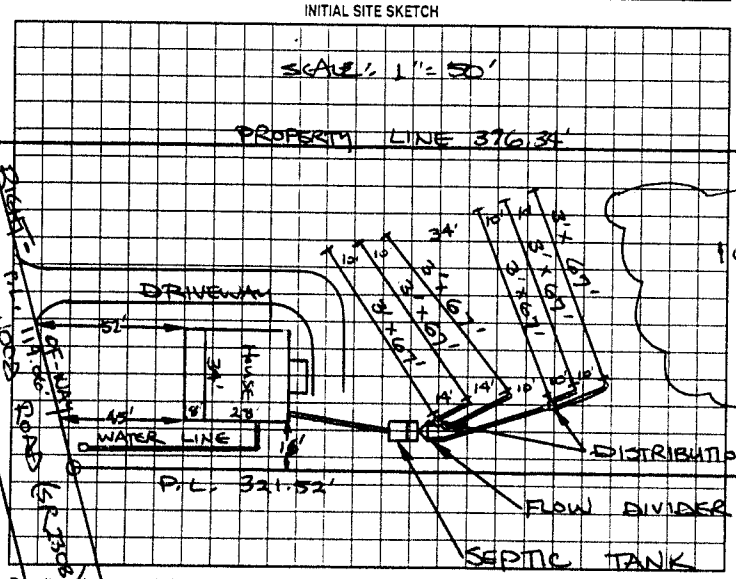

AS BUILT SKETCH

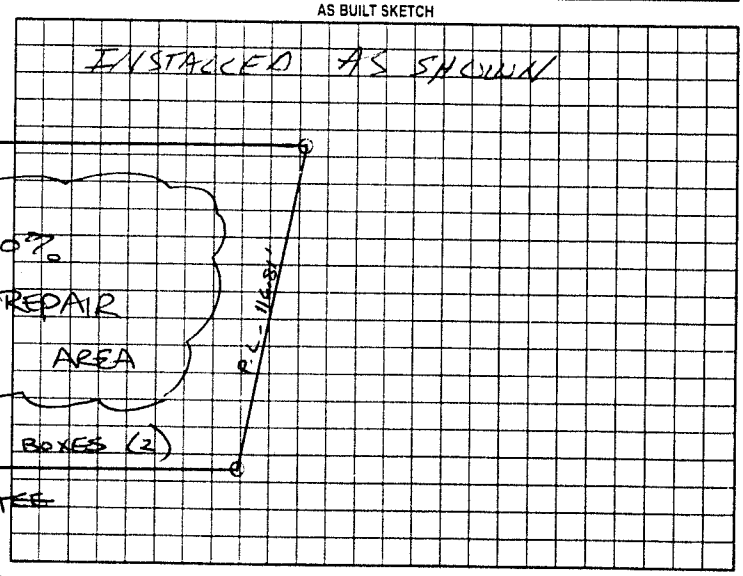

Permit can be suspended or revoked if any false information is supplied toward securing the permit/any unauthorized changes are made to the site/any unauthorized changes are made in the installation of the system. Improvement Permit with plat valid without expiration. Improvement Permit with site plan valid for sixty months. Authorization to Construct is valid for a period equal to that of Improvement Permit – not to exceed sixty months.

Signed: Craig Deal date Jan 3, 2001 Installed by: PCWELL BACKHOE SERVICE

Improvement Permit by: STEVE HEDRICK date 1-3-01 Operation Permit by: STEVE HEDRICK date 01-09-01

Authorization to Construct by: STEVE HEDRICK date 1-3-01 Existing System Inspection by: date

HEALTH DEPT. COPY WHITE OWNER COPY (FINAL) YELLOW OWNER COPY (INITIAL) PINK