IREDELL COUNTY HEALTH DEPARTMENT

STATESVILLE 704-878-5305 MOORESVILLE 704-664-5281

IMPROVEMENT PERMIT / AUTHORIZATION TO CONSTRUCT / OPERATION PERMIT / EXISTING SYSTEM INSPECTION

PERMIT# 095178 PIN# 4775 91 8492 (PT) DATE 4-27-01

OWNER OR CONTRACTOR A-I MOBILE HOMES PHONE: Business (704) 873-1014 Home

ADDRESS 590 MOCKSVILLE HWY, STATESVILLE, NC 28625

LOCATION US 64 EAST, TR BARRY OAK RD, TR ELMWOOD RD, 0.1 MILE ON RIGHT

SUBDIVISION I. CRAIG BEAL BLOCK / SECTION LOT 3 LOT AREA 0.656 ACRE SITE CLASS PS DESIGN FLOW 360 L.T.A.R. 0.20 GPD/FT²

Septic Tank: 1000 Gallons: STB 794 Date 3-24-01
Pump Tank: Gallons: PT Date
Pump Make: Model Serial No.
Nitrification Field: No Fields 1 Square Feet 1800 Linear Feet 600
No Lines EIGHT Trench Width 36" Max Trench Bottom Depth 20" Gravel Depth 12"


☑ New System ☐ Repair System Type: I, II, III, IV, V, VI
System Description: CONVENTIONAL GRAVITY
Repair System Description: 25% REDUCTION GRAVITY
Maintenance Agreement Required: ☐ Yes ☑ No
☐ Slab ☑ Crawl Space ☐ Basement w/plumbing ☐ Basement wo/plumbing

☐ House/Mod. Home ☑ Mobile Home ☐ Business ☐ Other
No. Bedrooms 3 No. Bathrooms 2 No. Employees

Water Supply: ☐ Individual ☑ Public ☐ Community

Comments/Conditions: USE ONE FLOW DIVIDER TEE TO ACHIEVE EQUAL DISTRIBUTION INTO TWO DISTRIBUTION BOXES FEEDING FOUR LINES EACH. INSTALL TANK AT GROUND LEVEL, KEEPING LINES 20" DEEP

INITIAL SITE SKETCH

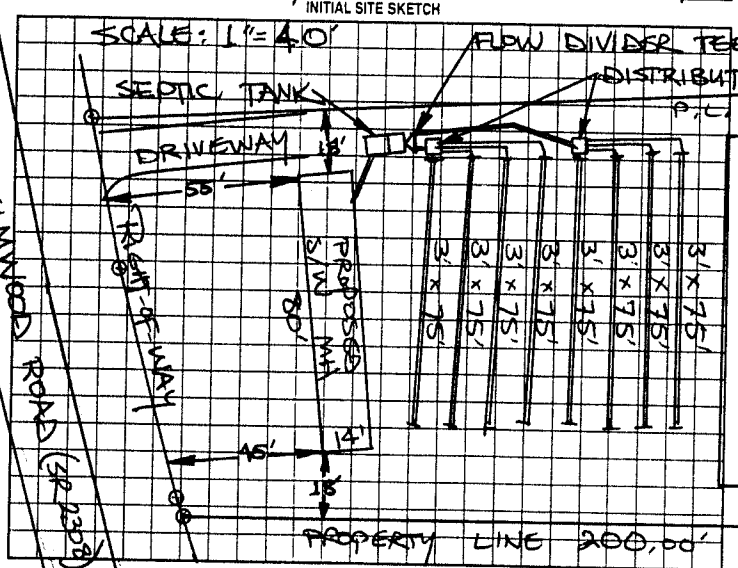

Comments/Conditions: SYSTEM INSTALLED WITH POLYLOK FILTER & MARKER
LAST 2 LINES IN TO DEEP, Pulled Stone Out & Packed Dirt to 20" Trench Bottom (C)

AS BUILT SKETCH

Permit can be suspended or revoked if any false information is supplied toward securing the permit/any unauthorized changes are made to the site/any unauthorized changes are made in the installation of the system. Improvement Permit with plat valid without expiration. Improvement Permit with site plan valid for sixty months. Authorization to Construct is valid for a period equal to that of Improvement Permit – not to exceed sixty months.

Signed: [signature] date 5-1-01 Installed by: Mitchell Heating & Cooling

Improvement Permit by: STEVE HEDRICK date 4-27-01 Operation Permit by: [signature] EST date 6-8-01

Authorization to Construct by: STEVE HEDRICK date 4-27-01 Existing System Inspection by: date

HEALTH DEPT. COPY: WHITE OWNER COPY (FINAL): YELLOW OWNER COPY (INITIAL): PINK