IREDELL COUNTY HEALTH DEPARTMENT

Statesville Office (704) 878-5305 Mooresville Office (704) 660-3625 PERMIT # 221364

IMPROVEMENT PERMIT / AUTHORIZATION TO CONSTRUCT / OPERATION PERMIT / EXISTING SYSTEM

PIN # 4775-95-8572

APPLICANT: ANDREA CAMPBELL APPLICANT ADDRESS: 391 OAK FOREST DR. STATESVILLE

SITE ADDRESS: SAME PHONE: 704-252-4765 ALT. PHONE:

SITE DIRECTIONS: HWY 64, TR BARRY OAK, TL OAK FOREST, C END ON L

SUBDIVISION: SECTION: LOT # LOT AREA: 1.213 AC DESIGN FLOW: 240 L.T.A.R.: .3(25R)

Septic Tank 1000 (gal) STB 760 Date 2/2/17
Pump Tank (gal) PT Date
Pump Make Model Serial #
Nitrification Fields 1 # Lines 2@100' Linear Ft: 200'
Trench Width 36" Max. Trench Bottom Depth 33" LowSide Gravel Depth


☒ New System ☐ Repair ☐ Expansion System Type: I II (III) IV V VI
System Description: 25% REDUCTION
Repair System Description: SAME
Maintenance Agreement Required: ☐ YES ☒ NO
☒ GRAVITY ☐ PRESSURE

☒ Residence No. Bedrooms 3
☐ Business No. Persons 4
☐ Other No. Employees
☐ Slab ☒ Crawl Space
☐ Basement w/plumbing ☐ Basement w/o plumbing

Water Supply: ☒ Private ☐ Public ☐ Community

Comments / Conditions:

INITIAL SITE SKETCH

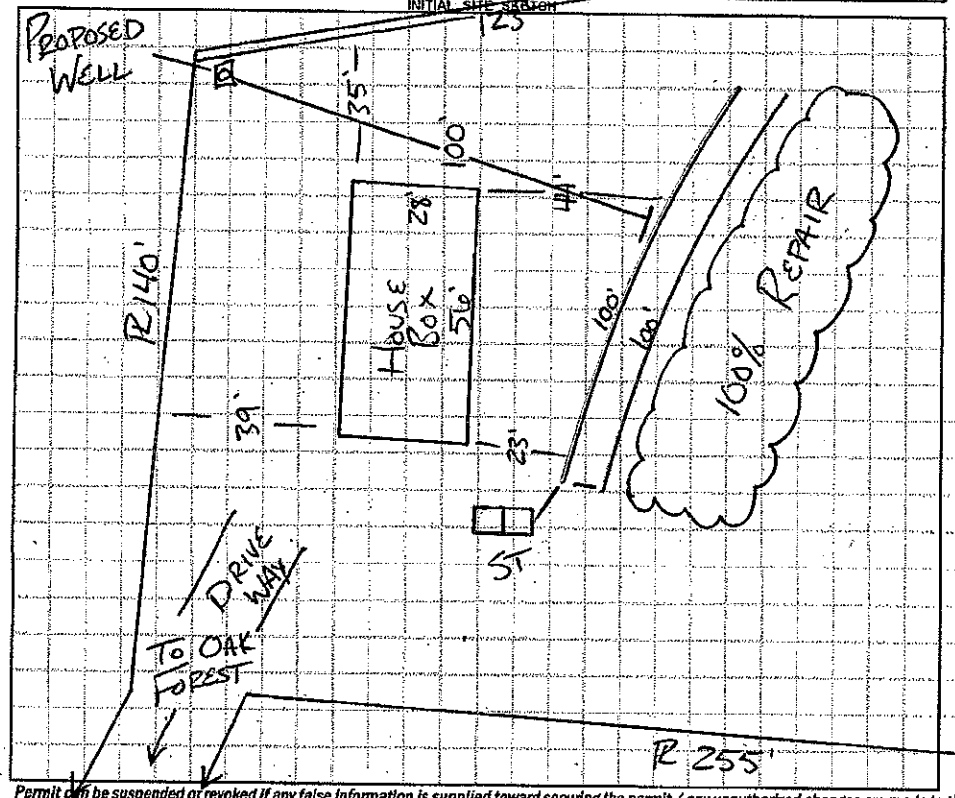

AS BUILT SKETCH

1"=40'

Installed Arc 36

As drawn

Permit can be suspended or revoked if any false information is supplied toward securing the permit / any unauthorized changes are made to the site / any unauthorized changes are made in the installation of the system. **CONTACT A LOCATOR SERVICE PRIOR TO ANY EXCAVATION**

☐ **IMPROVEMENT PERMIT** *with plat valid without expiration.* ☒ **IMPROVEMENT PERMIT** *with site plan valid for 60 mos.* ☒ **AUTHORIZATION TO CONSTRUCT** *valid for period equal to IMPROVEMENT PERMIT--not to exceed 60 mo.*

Owner / Applicant Signature: Andrea M. Campbell Date:

IMPROVEMENT PERMIT by: Date: 10-18-16

AUTHORIZATION TO CONSTRUCT by: Date: 10-21-16

Installed by: Abee's Grading & Clearing

OPERATION PERMIT by: Date: 2/11/17

Existing System Inspected by: Date:

Health Dept. Copy - WHITE Applicant (Final Approval) - YELLOW Applicant (Conditional Approval) - PINK