IREDELL COUNTY HEALTH DEPARTMENT

STATESVILLE 704-878-5305 MOORESVILLE 704-664-5281

IMPROVEMENT PERMIT / AUTHORIZATION TO CONSTRUCT / OPERATION PERMIT / EXISTING SYSTEM INSPECTION

PERMIT# 78226 PIN# 4775974146 DATE 3-31-99

OWNER OR CONTRACTOR James Meador PHONE: Business _____ Home 5289824

ADDRESS 314 Downing St. Troutman, N.C.

LOCATION 64E TR Wild Oak Th oak Forest .8 mi left

SUBDIVISION _____ BLOCK / SECTION _____ LOT _____ LOT AREA 8.13 acres SITE CLASS PS DESIGN FLOW 360 L.T.A.R. .3

Septic Tank: 1000 Gallons; STB 312 Date 5-27-99

Pump Tank: _____ Gallons; PT _____ Date _____

Pump Make: _____ Model _____ Serial No. _____

Nitrification Field: No Fields 1 Square Feet 1200 Linear Feet 400

No Lines 4 Trench Width 36" Max Trench Bottom Depth 36" Gravel Depth 12"

☑ New System ☐ Repair System Type: I, ☑ III, IV, V, VI

System Description: Conv. Gravity

Repair System Description: Pump to Conv

Maintenance Agreement Required: ☐ Yes ☑ No

☐ Slab ☑ Crawl Space ☐ Basement w/plumbing ☐ Basement wo/plumbing

☐ House/Mod. Home No. Bedrooms 3

☑ Mobile Home No. Bathrooms 2


☐ Business No. Employees _____

☐ Other _____

Water Supply:
☑ Individual
☐ Public
☐ Community


Comments/Conditions:

INITIAL SITE SKETCH

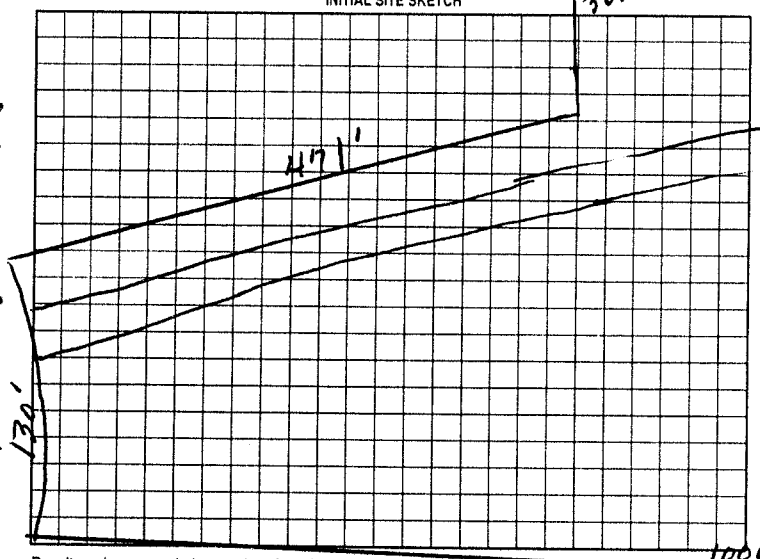

Comments/Conditions: Same as Initial Sketch

AS BUILT SKETCH

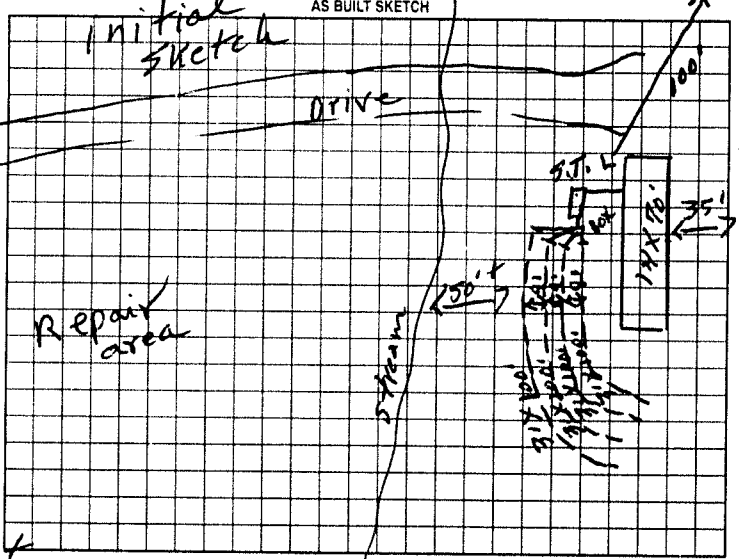

Permit can be suspended or revoked if any false information is supplied toward securing the permit, any unauthorized changes are made to the site, any unauthorized changes are made in the installation of the system. Improvement Permit with plat valid without expiration. Improvement Permit with site plan valid for sixty months. Authorization to Construct is valid for a period equal to that of Improvement Permit – not to exceed sixty months.

Signed: James C Meador date 4-8-99 Installed by: A & E Equipment

Improvement Permit by: P.C. moore date 3-31-99 Operation Permit by: P.C. moore date 9-21-99

Authorization to Construct by: P.C. moore date 3-31-99 Existing System Inspection By: _____ date _____

HEALTH DEPT. COPY WHITE OWNER COPY (FINAL) YELLOW OWNER COPY (INITIAL) PINK