IREDELL COUNTY HEALTH DEPARTMENT

THIS PERMIT VOIDS PREVIOUS ISSUED 1-20-98

STATESVILLE 704-878-5305 MOORESVILLE 704-664-5281

IMPROVEMENT PERMIT / AUTHORIZATION TO CONSTRUCT / OPERATION PERMIT / EXISTING SYSTEM INSPECTION

PERMIT# 071150 PIN# 4766 95 9764 DATE 2-17-98

OWNER OR CONTRACTOR G & G PROPERTIES PHONE: Business 873-1481 (OTMH) Home 873-4427 (KEN WEBB)

ADDRESS P.O. BOX 6386, STATESVILLE, NC 28677

LOCATION OLD MOCKSVILLE ROAD NE, TR CHESTNUT GROVE ROAD, TL EASTGATE DRIVE, 4TH LOT ON RIGHT

SUBDIVISION EASTGATE EST. BLOCK / SECTION ____ LOT 34 LOT AREA LIMITED SITE CLASS. PS DESIGN FLOW 480 L.T.A.R. 0.30 GAD/FT²

Septic Tank: 1000 Gallons; STB 1012 Date 1-1-98

Pump Tank: ____ Gallons; PT ____ Date ____

Pump Make: ____ Model ____ Serial No. ____

Nitrification Field: No. Fields 1 Square Feet 592 TO 1600 Linear Feet 400

No Lines SIX Trench Width 36 Max Trench Bottom Depth 36 Gravel Depth 6" SAND

☑ New System ☐ Repair System Type: I, II, III, IV, V, VI

System Description: CHAMBERED GRAVITY

Repair System Description: PPBPS-1-PP

Maintenance Agreement Required: ☐ Yes ☑ No

☐ House/Mod. Home ☑ Mobile Home ☐ Business ☐ Other

No. Bedrooms 4 No. Bathrooms 2 No. Employees ____


Water Supply: ☐ Individual ☑ Public ☐ Community

☐ Slab ☑ Crawl Space ☐ Basement w/plumbing ☐ Basement wo/plumbing


Comments:/Conditions: ① THIS PERMIT VOIDS PREVIOUS ISSUED 1-20-98 ② INSTALL SIXTY-SIX CHAMBERS IN SIX LINES AS SHOWN ON CONTOUR.

Comments:/Conditions:

INITIAL SITE SKETCH SCALE: 1" = 40'

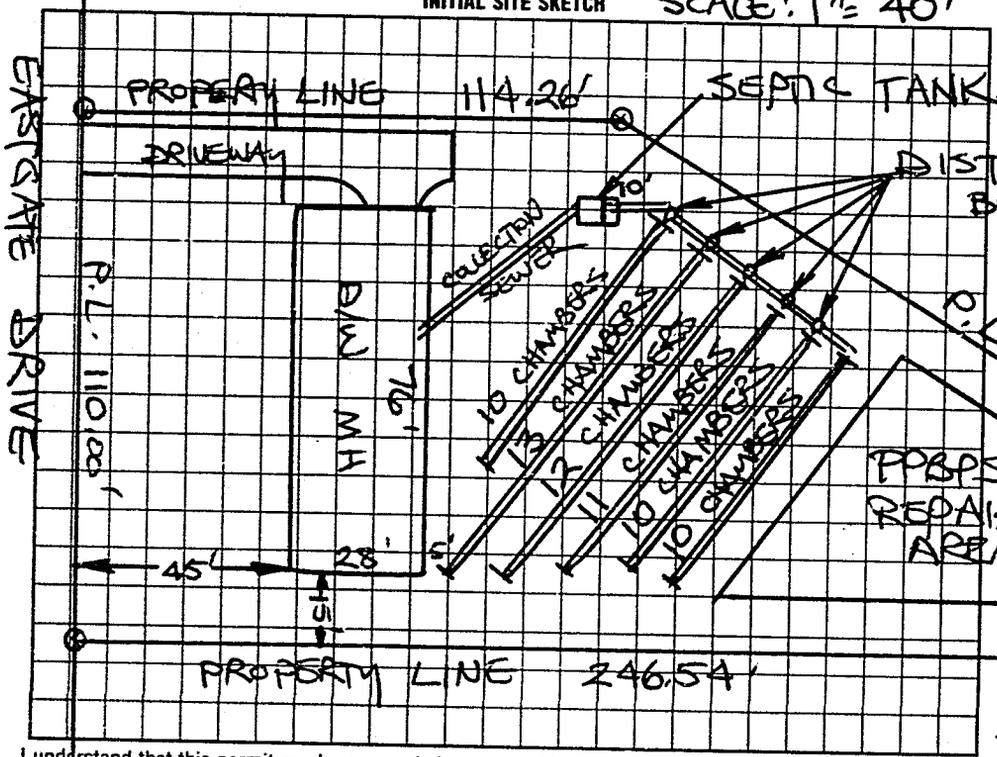

AS BUILT SKETCH

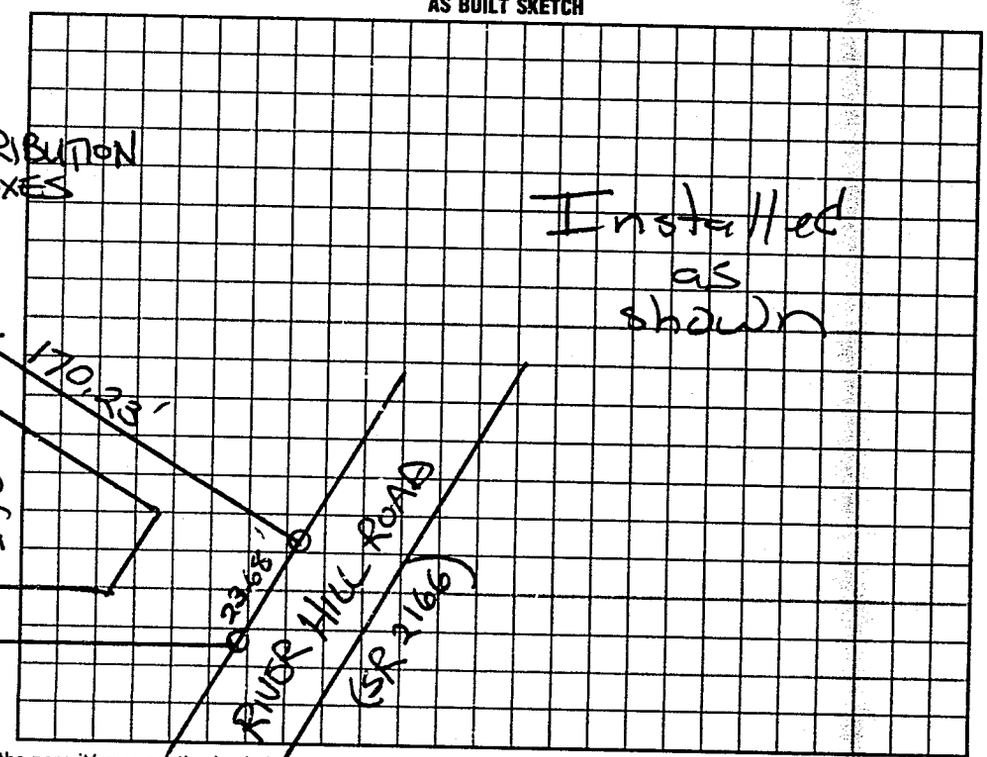

I understand that this permit can be suspended or revoked if any false information is supplied toward securing the permit/any unauthorized changes are made to the site/any unauthorized changes are made in the installation of the system. Improvement Permit with plat valid without expiration. Improvement Permit with site plan valid for sixty months. Authorization to Construct is valid for a period equal to that of Improvement Permit – not to exceed sixty months.

Signed: [signature] date ____

Improvement Permit by: STEVE HENDRICK date 2-17-98

Authorization to Construct by: STEVE HENDRICK date 2-17-98

Installed by: A-1 Backhoe

Operation Permit by: [signature] RS date 3-27-98

Existing System Inspection by: ____ date ____

HEALTH DEPT. COPY WHITE INSPECTION COPY (FINAL) GREEN OWNER COPY (FINAL) YELLOW INSPECTION COPY (INITIAL) PINK OWNER COPY (INITIAL) GOLD