IREDELL COUNTY HEALTH DEPARTMENT

STATESVILLE 704-878-5305 MOORESVILLE 704-664-5281

IMPROVEMENT PERMIT / AUTHORIZATION TO CONSTRUCT / OPERATION PERMIT / EXISTING SYSTEM INSPECTION

PERMIT# 091429 PIN# 4776046216 DATE 8-24-00

OWNER OR CONTRACTOR ANGELA KELLER PHONE: Business Home 873-2547

ADDRESS 770 RIVER HILL ROAD, STATESVILLE, NC, 28625

LOCATION OLD MOCKSVILLE ROAD, TR CHESTNUT GROVE ROAD, TL RIVERHILL RD, 1ST MH ON RIGHT

SUBDIVISION BLOCK / SECTION LOT LOT AREA 23.58 ACRES SITE CLASS PS DESIGN FLOW 360 L.T.A.R. 0.30 GPD/FT²

Septic Tank: EXISTING Gallons: STB Date

Pump Tank: Gallons: PT Date

Pump Make: Model Serial No.

Nitrification Field: No Fields 1 Square Feet 405 Linear Feet 135

No Lines ONE Trench Width 36" Max Trench Bottom Depth 42" +- Gravel Depth 12"

☐ New System ☐ Repair System Type: I (II) III IV V VI

System Description: CONVENTIONAL GRAVITY

Repair System Description: CONV. GRAVITY

Maintenance Agreement Required: ☐ Yes ☑ No

☐ House/Mod. Home ☑ Mobile Home ☐ Business ☐ Other

No. Bedrooms 3 No. Bathrooms 2 No. Employees


☐ Slab ☑ Crawl Space ☐ Basement w/plumbing ☐ Basement wo/plumbing

Water Supply: ☑ Individual ☐ Public ☐ Community WELL

Comments/Conditions: ① INSTALL NEW 3'x 135' LINE AS SHOWN, LEVEL TRENCH BOTTOM, FEED FIRST OUT OF NEW DIST. BOX (IF NECESSARY) ② INSTALL NEW SANITARY TEE IN TANK.

Comments/Conditions: SANITARY TEE NOT INSTALLED - EXISTING TEE STILL IN PLACE.

INITIAL SITE SKETCH

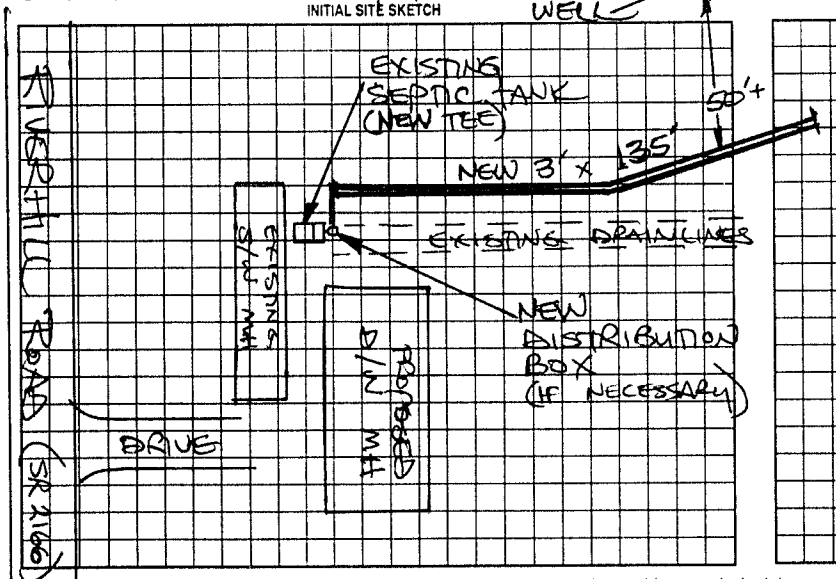

AS BUILT SKETCH

SYSTEM EXPANDED ACCORDING TO INITIAL SITE SKETCH

Permit can be suspended or revoked if any false information is supplied toward securing the permit/any unauthorized changes are made to the site/any unauthorized changes are made in the installation of the system. Improvement Permit with plan valid without expiration. Improvement Permit with site plan valid for sixty months. Authorization to Construct is valid for a period equal to that of Improvement Permit – not to exceed sixty months.

Signed: James Stadler date 8-25-00 Installed by: A-1 BACKHOE

Improvement Permit by: STEVE HEDRICK date 8-24-00 Operation Permit by: STEVE HEDRICK date 8-30-00

Authorization to Construct by: STEVE HEDRICK date 8-24-00 Existing System Inspection by: date

HEALTH DEPT. COPY: WHITE OWNER COPY (FINAL): YELLOW OWNER COPY (INITIAL): PINK