IREDELL COUNTY HEALTH DEPARTMENT

Statesville Phone TR 3-7271 Mooresville Phone NO 3-1271

PERMIT TO INSTALL SEPTIC TANK

Permit NO. 198 Permit Date _____ 19 71

Owner NELSON BROWN Address 218 BOST

Installed By FLOYD ADAMS Address TAYLORSVILLE, NC.

Location of Property ~~INDEPENDENCE LAKE~~ - CEDARMOUNT ROAD

RIVER HILL HEIGHTS OFF STATE ROAD


A 2166

Tank		Capacity		Length of Lines		Fixtures	
Block	( )	1000	( )	225'	( )	No. of Baths	(1½)
Precast	(✓)	1250	( )	250'	( ).	Dishwasher	(no)
		1500	( )	Other APPROX 270 sq. ft		Garbage Grdr.	(no)
		Other _____				Other under	

NOTIFY HEALTH DEPARTMENT AT LEAST EIGHT HOURS BEFORE TANK IS TO BE INSPECTED.

Final Inspection _____ 19 7[illegible] Approved ( ) Disapproved ( )

Remarks Another system in front of house not charted

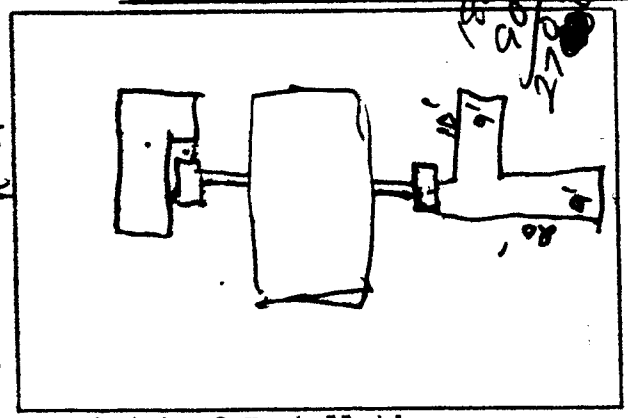

Sketch of Installation

Sanitarian