IREDELL COUNTY HEALTH DEPARTMENT

STATESVILLE 704-878-5305 MOORESVILLE 704-664-5281

IMPROVEMENT PERMIT / AUTHORIZATION TO CONSTRUCT / OPERATION PERMIT / EXISTING SYSTEM INSPECTION

PERMIT# 87774 PIN# 4766959764 DATE 2-14-00

OWNER OR CONTRACTOR Stikeleather & Associates PHONE: Business 876-6847 Home

ADDRESS PO Box 6286 Statesville, N.C.

LOCATION 64E TL Riverhill TL Chestnut Grove TR Eastgate 9th Rt

SUBDIVISION Eastgate BLOCK / SECTION LOT 29 LOT AREA 20831 SITE CLASS. PS DESIGN FLOW 240 L.T.A.R. .3

Septic Tank: 1000 Gallons; STB 825 Date 2-1-00
Pump Tank: Gallons; PT Date
Pump Make: Model Serial No.
Nitrification Field: No Fields 1 Square Feet 810 Linear Feet 270
No Lines 4 Trench Width 36" Max Trench Bottom Depth 36" Gravel Depth 12"

☑ New System ☐ Repair System Type: I, II, III, IV, V, VI
System Description: Conv. Gravity
Repair System Description: Pump To
Maintenance Agreement Required: ☐ Yes ☐ No


☑ House/Mod. Home No. Bedrooms 3
☑ Mobile Home No. Bathrooms 2
☐ Business No. Employees
☐ Other
☐ Slab ☑ Crawl Space ☐ Basement w/plumbing ☐ Basement wo/plumbing

Water Supply: ☐ Individual ☑ Public ☐ Community


Comments/Conditions:

Comments/Conditions ① SEPTIC TANK WITH RISERS INSTALLED USING "POLYLOK" FILTER ② SEPTIC TANK CONCRETE APPEARED TO BE "GREEN" OR UNCURED ③ SYSTEM SIZED FOR TWO BEDROOMS ONLY

INITIAL SITE SKETCH

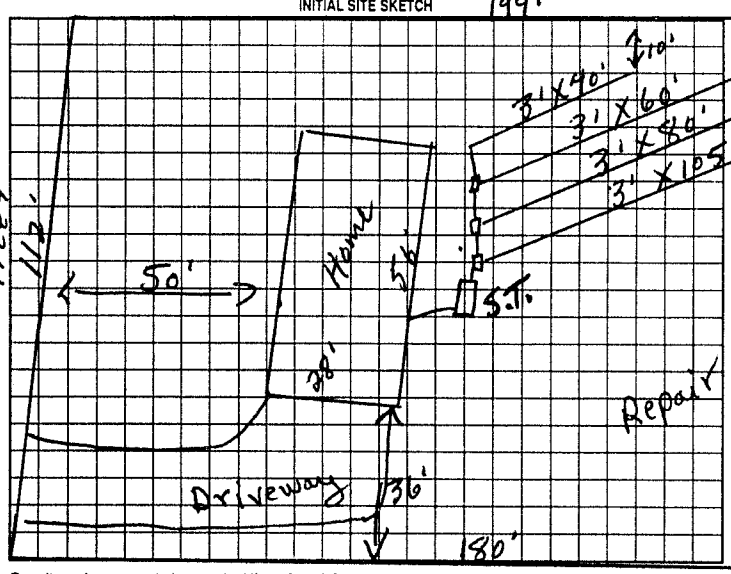

AS BUILT SKETCH

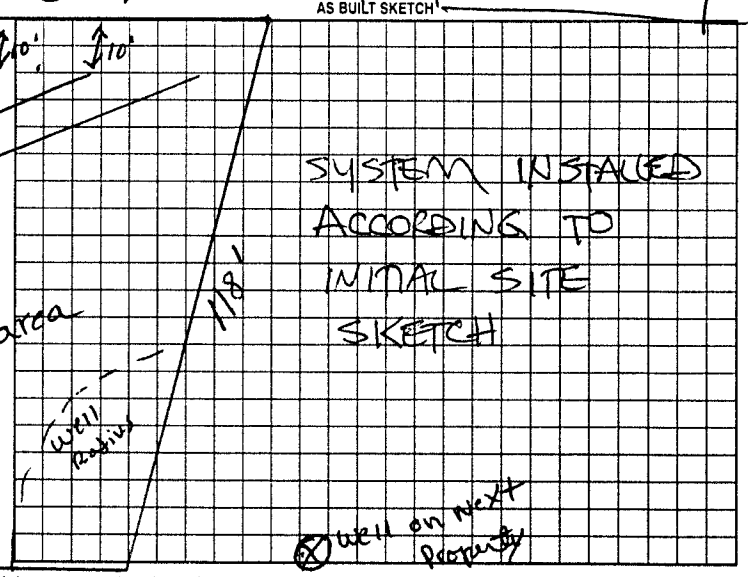

Permit can be suspended or revoked if any false information is supplied toward securing the permit/any unauthorized changes are made to the site/any unauthorized changes are made in the installation of the system. Improvement Permit with plat valid without expiration. Improvement Permit with site plan valid for sixty months. Authorization to Construct is valid for a period equal to that of Improvement Permit – not to exceed sixty months.

Signed: Ben Stikeleather date 2-16-00 Installed by: C & W GRADING

Improvement Permit by: P. C. Moore date 2-14-00 Operation Permit by: STEVE HEDRICK date 3-13-00

Authorization to Construct by: P. C. Moore date 2-14-00 Existing System Inspection by: date

HEALTH DEPT. COPY: WHITE OWNER COPY (FINAL): YELLOW OWNER COPY (INITIAL): PINK