IREDELL COUNTY HEALTH DEPARTMENT

STATESVILLE 704-878-5305 MOORESVILLE 704-664-5281

IMPROVEMENT PERMIT / AUTHORIZATION TO CONSTRUCT / OPERATION PERMIT / EXISTING SYSTEM INSPECTION

PERMIT# 98764 PIN# 4776 05 4037 DATE 4-24-00

OWNER OR CONTRACTOR Pearline Harris PHONE: Business Home 704 682 0304

ADDRESS 927 meeting St. Statesville N.C.

LOCATION 6 HE TL Riverhill RD past East middle school TR Independence Loop 1st lot RT.

SUBDIVISION Riverhill BLOCK / SECTION LOT 1 LOT AREA 1.41 acres SITE CLASS PS DESIGN FLOW 360 L.T.A.R. .3

Septic Tank: 1000 Gallons; STB Hughes 794 Date 2-27-00

Pump Tank: Gallons; PT Date

Pump Make: Model Serial No.

Nitrification Field: No Fields 1 Square Feet 900 Linear Feet 300

No Lines 4 Trench Width 36" Max Trench Bottom Depth 36" Gravel Depth N/A

☑ New System ☐ Repair System Type: I, II, III, IV, V, VI

System Description: Gravity 25% Red.

Repair System Description: Pump To 25% Red.

Maintenance Agreement Required: ☐ Yes ☐ No

☑ House/Mod. Home ☐ Mobile Home ☐ Business ☐ Other

No. Bedrooms 3 No. Bathrooms 2 No. Employees


☐ Slab ☑ Crawl Space ☐ Basement w/plumbing ☐ Basement wo/plumbing

Water Supply: ☐ Individual ☑ Public ☐ Community


Comments/Conditions:

Comments/Conditions: Installed as shown below w/ E-Z Lay

INITIAL SITE SKETCH

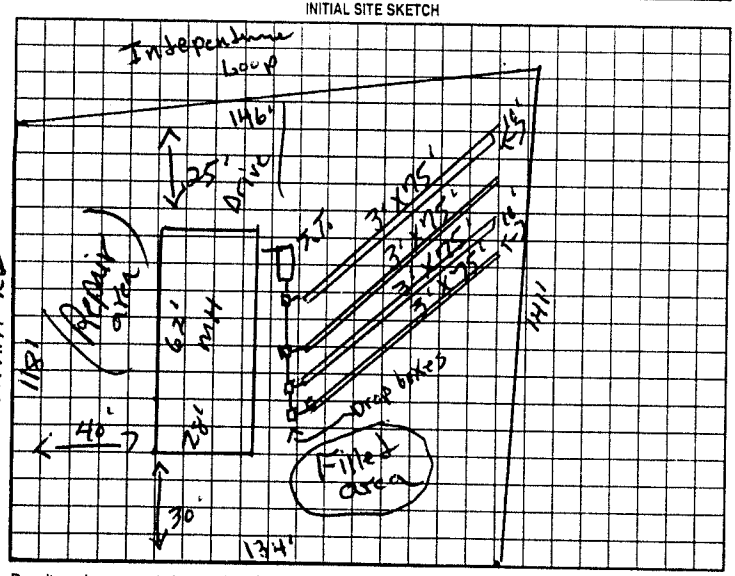

AS BUILT SKETCH

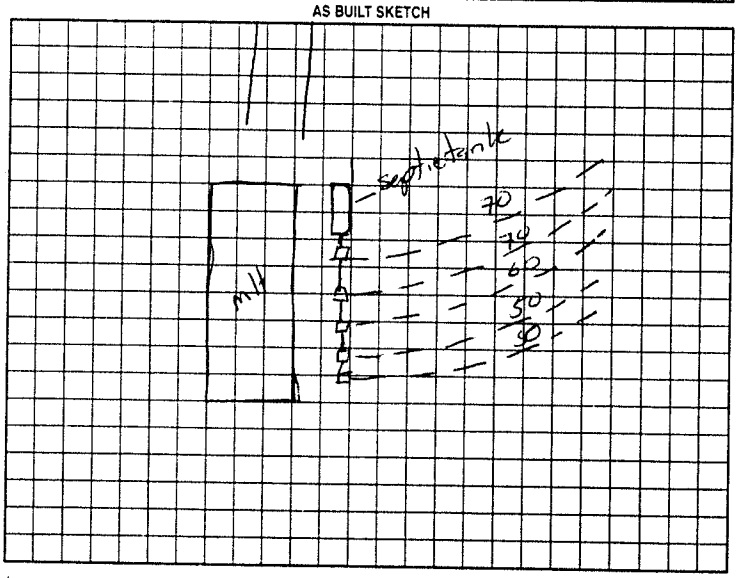

Permit can be suspended or revoked if any false information is supplied toward securing the permit/any unauthorized changes are made to the site/any unauthorized changes are made in the installation of the system. Improvement Permit with plat valid without expiration. Improvement Permit with site plan valid for sixty months. Authorization to Construct is valid for a period equal to that of Improvement Permit – not to exceed sixty months.

Signed: Pearline Harris 4/28-00 date

Improvement Permit by: P.C. Moore date 4-24-00

Authorization to Construct by: P.C. Moore date 4-24-00

Installed by: BCS Septic Service

Operation Permit by: M4 COJ RS date 5-16-00

Existing System Inspection by: date

HEALTH DEPT. COPY: WHITE OWNER COPY (FINAL): YELLOW OWNER COPY (INITIAL): PINK