IREDELL COUNTY HEALTH DEPARTMENT

STATESVILLE 704-878-5305 MOORESVILLE 704-664-5281

IMPROVEMENT PERMIT / AUTHORIZATION TO CONSTRUCT / OPERATION PERMIT / EXISTING SYSTEM INSPECTION

PERMIT# REPAIR PIN# 4776-05-5010 DATE 9-15-05

OWNER OR CONTRACTOR ADDIE M. JAMES PHONE: Business 704-450-5898 Home

ADDRESS 110 INDEPENDANCE LOOP, STATESVILLE NC 28677

LOCATION US64 EAST, TL RIVER HILL ROAD, TR INDEPENDANCE LOOP (1ST), 2ND HOUSE ON RIGHT

SUBDIVISION RIVER HILL BLOCK / SECTION LOT 2 LOT AREA 100' X 150' SITE CLASS. 1-5 DESIGN FLOW 360 L.T.A.R EXISTING (.3 GPD/FT²)

Septic Tank: EXISTING Gallons; STB Date

Pump Tank: Gallons; PT Date

Pump Make: Model Serial No.

Nitrification Field: No Fields 1 Square Feet 360 Linear Feet 120

No Lines TWO Trench Width 36" Max Trench Bottom Depth 36" +/- Gravel Depth N/A

☑ New System ☑ Repair System Type: I (II), III, IV, V, VI

System Description:

Repair System Description: 25% REDUCTION, GRAVITY

Maintenance Agreement Required: ☐ Yes ☑ No

☑ House/Mod. Home No. Bedrooms 3

☐ Mobile Home No. Bathrooms

☐ Business No. Employees

☐ Other


☐ Slab ☑ Crawl Space ☐ Basement w/plumbing ☐ Basement wo/plumbing

Water Supply: ☐ Individual ☐ Public ☑ Community


Comments/Conditions: ① REPLACE SANITARY TEE IN SEPTIC TANK IF NECESSARY ② INSTALL NEW DISTRIBUTION AT LOCATION SHOWN AS SHALLOW AS POSSIBLE ③ USE 25% REDUCTION SYSTEM

Comments/Conditions: Possible House Leaks - Need Plumber to check
Reseed disturbed area ASAP

INITIAL SITE SKETCH ~ SCALE: 1" = 30'

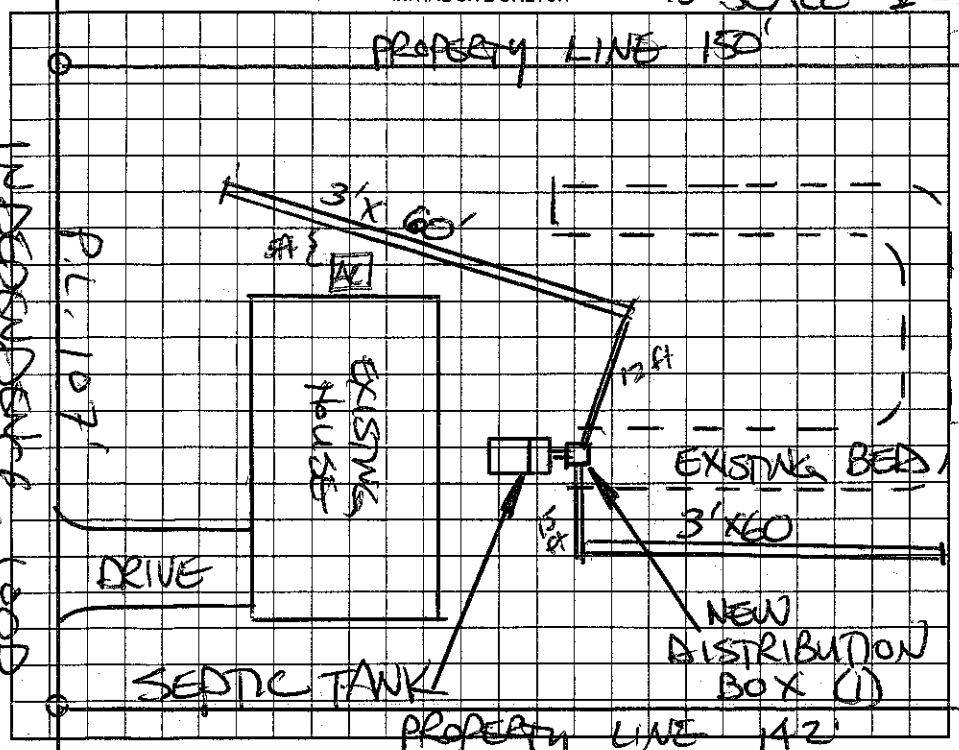

AS BUILT SKETCH

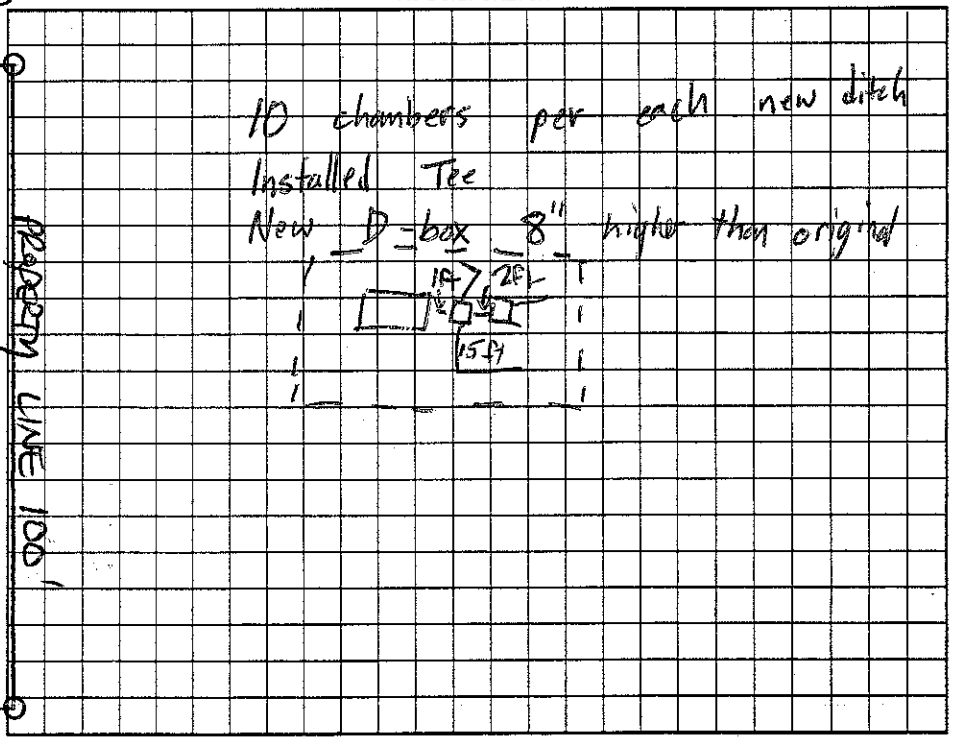

Permit can be suspended or revoked if any false information is supplied toward securing the permit/any unauthorized changes are made to the site/any unauthorized changes are made in the installation of the system. Improvement Permit with plat valid without expiration. Improvement Permit with site plan valid for sixty months. Authorization to Construct is valid for a period equal to that of Improvement Permit – not to exceed sixty months.

Signed: [signature] date 9-15-05 Installed by: Wes Lytton

Improvement Permit by: STEVE HENDRICK date 9-15-05 Operation Permit by: James Stewart date 10-5-05

Authorization to Construct by: STEVE HENDRICK date 9-15-05 Existing System Inspection by: date

HEALTH DEPT. COPY: WHITE OWNER COPY (FINAL): YELLOW OWNER COPY (INITIAL): PINK