IREDELL COUNTY HEALTH DEPARTMENT

Statesville Phone TR 3-7271 Mooresville Phone No. 664-5281

PERMIT TO INSTALL SEPTIC TANK

Permit No. [illegible] Permit Date 2-22 1973

Owner BLDR. NELSON BROWN Address STATESVILLE, N.C.

Installed By HARLEE LACKEY Address STONY POINT, NC


Location of Property 64 S - LEFT ON RIDER HILL RD - RIVER HILL HEIGHTS - LOT - #33

Tank		Capacity		Length of Lines		Fixtures	
Block	( )	1000	(✓)	225'	( )	No. of Baths	(1½)
Precast	(✓)	1250	( )	250'	( )	Dishwasher	( )
		1500	( )	Other 300 900 Sq ft.		Garbage Grdr.	( )
		Other				Other	

NOTIFY HEALTH DEPARTMENT AT LEAST EIGHT HOURS BEFORE TANK IS TO BE INSPECTED.

Final Inspection 2-22 1973 Approved (✓) Disapproved ( )

Remarks Community Water Supply

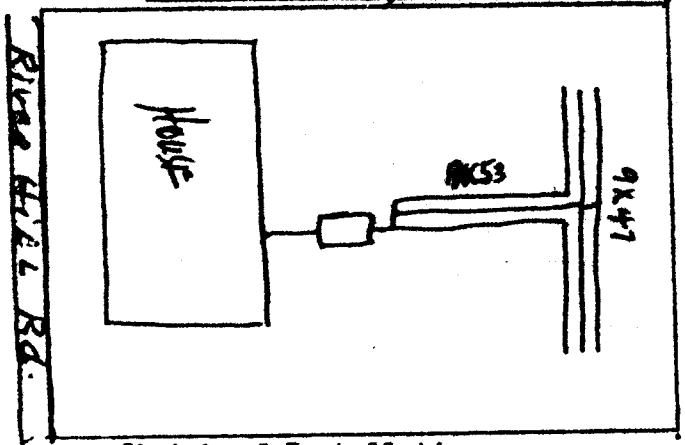

Sketch of Installation

[signature] Sanitarian