IREDELL COUNTY HEALTH DEPARTMENT

Statesville Phone TR 3-7271 Mooresville Phone NO 3-1271

PERMIT TO INSTALL SEPTIC TANK

Permit NO. 55 Permit Date 8-4 1972

Owner NELSON BROWN Address STATESVILLE, NC.

Installed By C. R. HOKE Address STATESVILLE, NC

Location of Property RIVER HILL HEIGHTS


LOT. #37

Tank		Capacity		Length of Lines		Fixtures	
Block	( )	1000	(✓)	225'	( )	No. of Baths	(3)
Precast	(✓)	1250	( )	250'	( )	Dishwasher	( )
		1500	( )	Other 300		Garbage Grdr.	( )
		Other		900 Sq Ft.		Other	

NOTIFY HEALTH DEPARTMENT AT LEAST EIGHT HOURS BEFORE TANK IS TO BE INSPECTED.

Final Inspection 8-4 1972 Approved (✓) Disapproved ( )

Remarks Community Water Supply

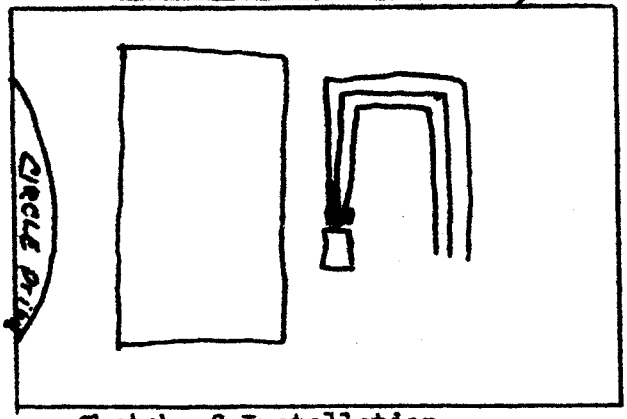

Sketch of Installation

Glenn Fox Jr.

Sanitarian