IREDELL COUNTY HEALTH DEPARTMENT

Statesville Phone TR 3-7271 Mooresville Phone No. 664-5281

PERMIT TO INSTALL SEPTIC TANK

Permit No. 131 Permit Date 1-3 19 73

Owner NELSON BROWN Address STATESVILLE, N.C

Installed By Raymond Akins Address Hiddenite, N.C

Location of Property RIVER HILL HEIGHTS


Lot #38

Tank		Capacity		Length of Lines		Fixtures	
Block	( )	1000	(✓)	225'	( )	No. of Baths	(1½)
Precast	(✓)	1250	( )	250'	( )	Dishwasher	( )
		1500	( )	Other 300 900 SQ FT		Garbage Grdr.	( )
		Other				Other	

NOTIFY HEALTH DEPARTMENT AT LEAST EIGHT HOURS BEFORE TANK IS TO BE INSPECTED.

Final Inspection 1-3 1973 Approved (✓) Disapprcved ( )

Remarks Community Water Supply

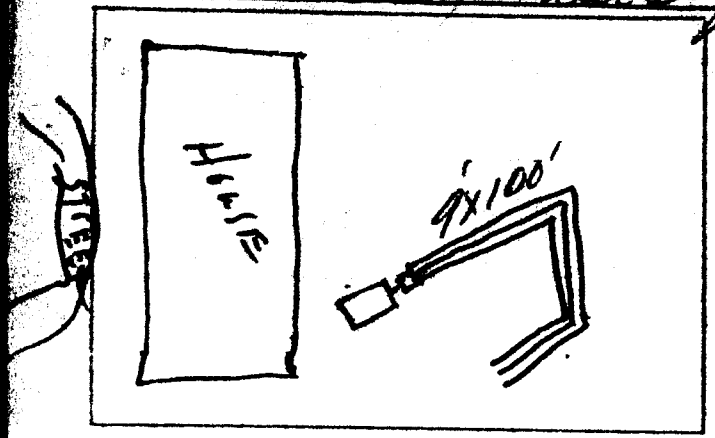

Sketch of Installation

Glenn Long
Sanitarian