IREDELL COUNTY HEALTH DEPARTMENT

STATESVILLE 704-878-5305 MOORESVILLE 704-664-5281

IMPROVEMENT PERMIT / CERTIFICATE OF COMPLETION / OPERATION PERMIT / EXISTING SYSTEM INSPECTION

PROPERTY DESCRIPTION NO. 1984-[illegible]29 DATE 12-19-94 TAX MAP NO. 11E-2-A-30 Watershed: ☐ Yes ☒ No

OWNER OR CONTRACTOR Dexter Holmes PHONE: Business _____ Home 871-4525

ADDRESS 640 E Sharpe St Sta.

LOCATION 64E Riverhill Rd Cross I-40 1mi Rt

SUBDIVISION Riverhill Heights BLOCK / SECTION — LOT 30 LOT AREA 15000sf SITE CLASS. PS DESIGN FLOW 360 L.T.A.R. .3

Septic Tank: 1000 Gallons; STB 1012 Date 45-94

Pump Tank: _____ Gallons; PT _____ Date _____

Pump Make: _____ Model _____ Serial No. _____

Nitrification Field: No Fields 1 Square Feet 1200 Linear Feet 400

No Lines 5 Trench Width 36" Max Trench Bottom Depth 36" Gravel Depth 12"

☒ New System ☐ Repair System Type: I, II, III, IV, V, VI

System Description: Conv. Gravity

Repair System Description: Pump To Perus Block

Maintenance Agreement Required: ☐ Yes ☒ No panel

☒ House/Mod. Home ☐ Mobile Home ☐ Business ☐ Other

No. Bedrooms 3 No. Bathrooms 2½ No. Employees ____


☐ Slab ☒ Crawl Space ☐ Basement w/plumbing ☐ Basement wo/plumbing

Water Supply: ☐ individual ☒ Community ☐ Public

Comments:


Comments:
Note: No Deck / Gazebo on Back of House
Tank sets center of House as shown

INITIAL SITE SKETCH

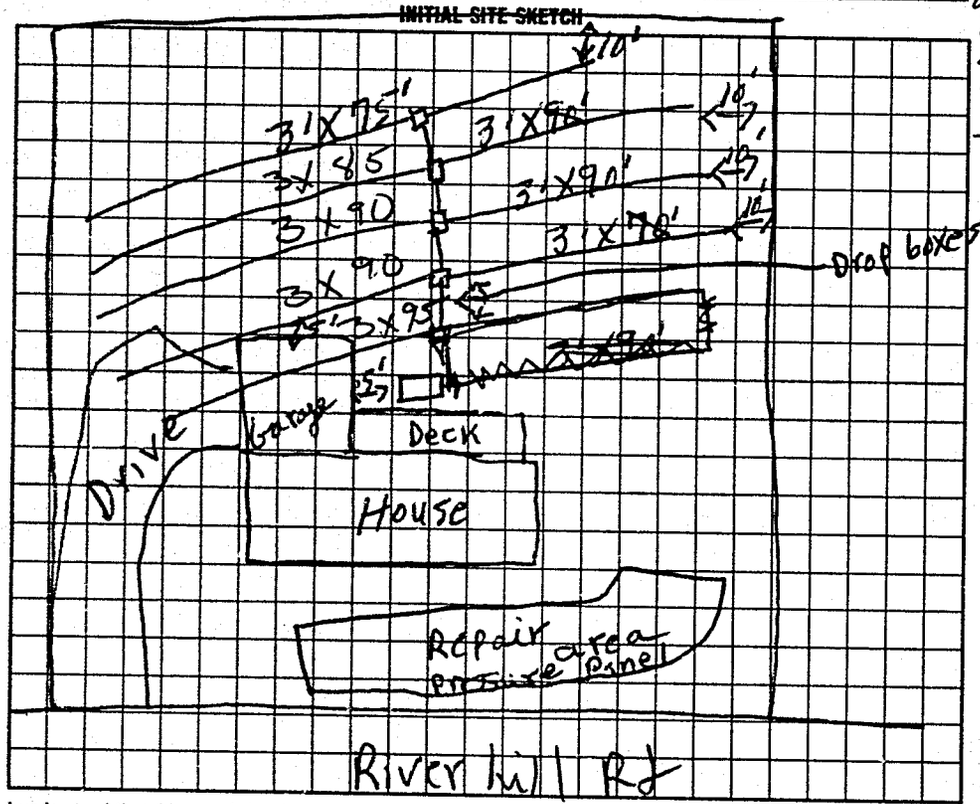

95
90
90
85
75

AS BUILT SKETCH

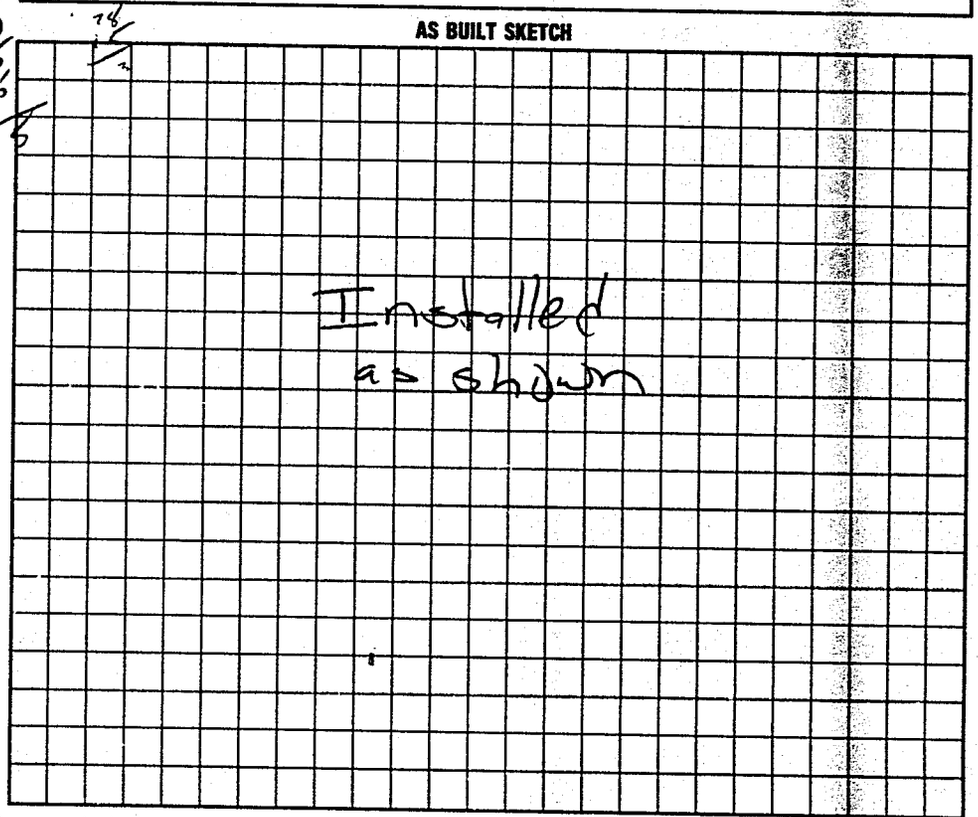

I understand that this permit can be suspended or revoked if any false information is supplied toward securing the permit/any unauthorized changes are made to the site/any unauthorized changes are made in the installation of the system. Improvement Permit is valid for 60 months from date of issuance.

Signed: X Phyllis S. Holmes

Improvement Permit by: J. C. Moore date 12-19-94

Existing System Inspection by: _____ date _____

Installed by: Steve Jordan

Certificate of Completion by: _____ date _____

Operation Permit by: Mark Cutts RS date 6-18-98

HEALTH DEPT. COPY: WHITE INSPECTION COPY (FINAL): GREEN OWNER COPY (FINAL): YELLOW INSPECTION COPY (INITIAL): PINK OWNER COPY (INITIAL): GOLD