IREDELL COUNTY HEALTH DEPARTMENT

STATESVILLE 704-878-5305 MOORESVILLE 704-664-5281

IMPROVEMENT PERMIT / AUTHORIZATION TO CONSTRUCT / OPERATION PERMIT / EXISTING SYSTEM INSPECTION

PERMIT# 83901 PIN# 4766959764 DATE 9-27-99

OWNER OR CONTRACTOR Strickleather + Associates PHONE: Business 876 6847 Home

ADDRESS PO Box 6286 Sta N.C.

LOCATION 64E TL River Hill TL Chestnut Grove TR Eastgate extnt

SUBDIVISION Eastgate Est. BLOCK / SECTION LOT 20 LOT AREA 25,584 SF SITE CLASS PS DESIGN FLOW 360 L.T.A.R. .3

Septic Tank: 1000 Gallons; STB 1012 Date 8-15-99 ☑ New System ☐ Repair System Type: I. II. ☑ IV. V. VI

Pump Tank: Gallons; PT Date System Description: Gravity 25% Reduct

Pump Make: Model Serial No. Repair System Description:

Nitrification Field: No Fields 1 Square Feet 900 Linear Feet 300 Maintenance Agreement Required: ☐ Yes ☑ No

No Lines 4 Trench Width 36" Max Trench Bottom Depth 36" Gravel Depth N/A

☐ House/Mod. Home No. Bedrooms 3

☑ Mobile Home No. Bathrooms 2

☐ Business No. Employees

☐ Other


☐ Slab ☑ Crawl Space ☐ Basement w/plumbing ☐ Basement wo/plumbing

Water Supply: ☐ Individual ☑ Public ☐ Community


Comments:/Conditions:

Comments:/Conditions.

INITIAL SITE SKETCH

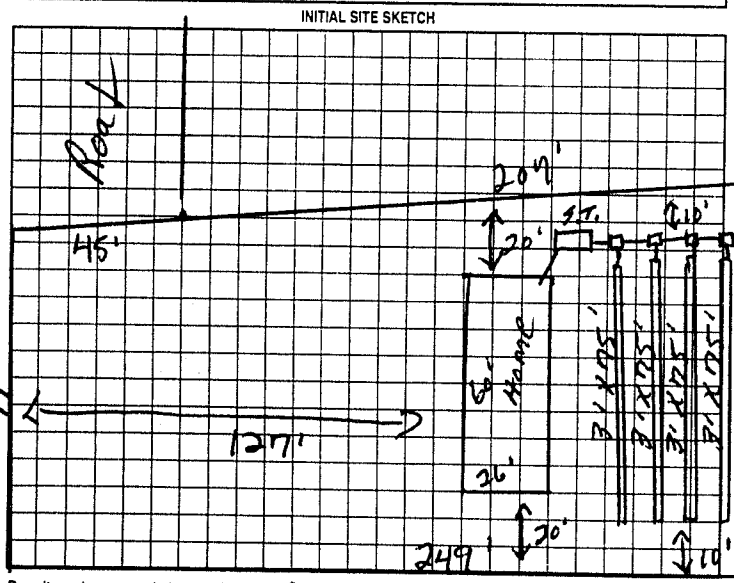

AS BUILT SKETCH

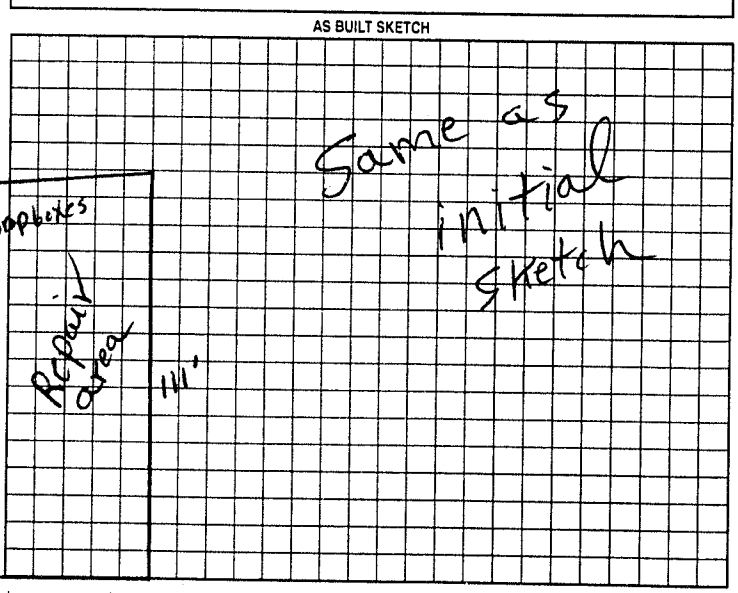

Permit can be suspended or revoked if any false information is supplied toward securing the permit/any unauthorized changes are made to the site/any unauthorized changes are made in the installation of the system. Improvement Permit with plat valid without expiration. Improvement Permit with site plan valid for sixty months. Authorization to Construct is valid for a period equal to that of Improvement Permit – not to exceed sixty months.

Signed: David Strickleather date 10-7-99 Installed by: C + W Grading + Septic

Improvement Permit by: J. C. Moore date 9-27-99 Operation Permit by: J. C. Moore date 10-29-99

Authorization to Construct by: J. C. Moore date 9-27-99 Existing System Inspection by: date

HEALTH DEPT. COPY: WHITE OWNER COPY (FINAL): YELLOW OWNER COPY (INITIAL): PINK