IREDELL COUNTY HEALTH DEPARTMENT

Statesville Phone TR 3-7271 Mooresville Phone No. 664-5281

PERMIT TO INSTALL SEPTIC TANK

Permit No. Plat 133 Permit Date 1-5 1973

Owner NELSON BROWN Address STATESVILLE, N.C.

Installed By Raymond Adams Address Hiddenite, N. C.

Location of Property RIVER HILL HEIGHTS


LOT. # 49

Tank		Capacity		Length of Lines		Fixtures	
Block	( )	1000	(✓)	225'	( )	No. of Baths	(✓)
Precast	(✓)	1250	( )	250'	( )	Dishwasher	( )
		1500	( )	Other 300 900 Sq Ft.		Garbage Grdr.	( )
		Other				Other	

NOTIFY HEALTH DEPARTMENT AT LEAST EIGHT HOURS BEFORE TANK IS TO BE INSPECTED.

Final Inspection 1-5 1973 Approved ( ) Disapprcved ( )

Remarks Community Water Supply

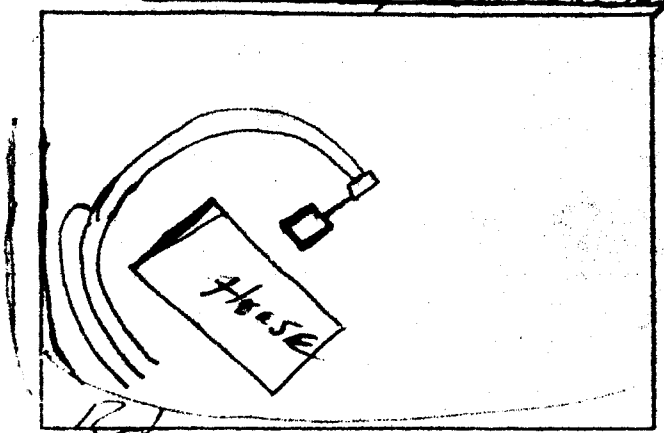

Sketch of Installation

Builder Rushing Contractor - Nitrification field filled with water - Contractor pumped lines - (Builders Responsibility)

Sanitarian