IREDELL COUNTY HEALTH DEPARTMENT

Statesville Phone TR 3-7271 Mooresville Phone NO 3-1271

PERMIT TO INSTALL SEPTIC TANK

Permit No. 329 Permit Date _____ 19__

Owner Nelson Brown Address _____

Installed By Raymond Adams Address _____


Location of Property River Hill Heights . Lot # 26

Tank		Capacity		Length of Lines		Fixtures	
Block	( )	1000	( )	225'	( )	No. of Baths	(1)
Precast	(✓)	1250	( )	250'	( )	Dishwasher	( )
		1500	( )	Other 700 sq'		Garbage Grdr.	( )
		Other _____				Other _____	

NOTIFY HEALTH DEPARTMENT AT LEAST EIGHT HOURS BEFORE TANK IS TO BE INSPECTED.

Final Inspection 11-5-[illegible] Approved (✓) Disapproved ( )

Remarks Central Water

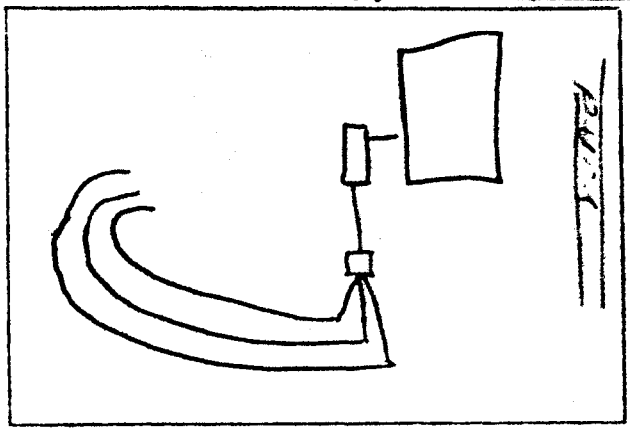

Sketch of Installation

Rex S Hall

Sanitarian