2:00

IREDELL COUNTY HEALTH DEPARTMENT

STATESVILLE 704-878-5305 MOORESVILLE 704-664-5281

IMPROVEMENT PERMIT / CERTIFICATE OF COMPLETION / OPERATION PERMIT / EXISTING SYSTEM INSPECTION

PROPERTY DESCRIPTION NO. 22466 DATE 11-15-95 TAX MAP NO. 11E-3-A-18 Watershed: ☐ Yes ☒ No

OWNER OR CONTRACTOR Hector Hamel PHONE: Business _____ Home 873-4897

ADDRESS 626 B Walnut St Sta

LOCATION 64E TL Riverhill Rd East Chestnut 1/2mi Rt

SUBDIVISION Clover Downs BLOCK / SECTION _____ LOT 18 LOT AREA 100X200 SITE CLASS PS DESIGN FLOW 360 L.T.A.R. .28

Septic Tank: 1000 Gallons; STB 744 Date 10-11-95

Pump Tank: _____ Gallons; PT _____ Date _____

Pump Make: _____ Model 1044 Serial No. 348

Nitrification Field: No Fields 6 Square Feet ~~1200~~ Linear Feet ~~3600~~

No Lines 5 Trench Width 36" Max Trench Bottom Depth 36" Gravel Depth N/A

☐ New System ☐ Repair System Type: I, II, III, IV, V, VI

System Description: Gravity Chambers

Repair System Description: Gravity Panel + Pump

Maintenance Agreement Required: ☐ Yes ☐ No TO Pump

☐ House/Mod. Home ☐ Mobile Home ☐ Business ☐ Other

No. Bedrooms 3 No. Bathrooms 2 No. Employees ____


☐ Slab ☒ Crawl Space ☐ Basement w/plumbing ☐ Basement wo/plumbing

Water Supply: ☐ Individual ☐ Community ☒ Public


Comments: Line Equals ~~1200~~ 464 Linear feet conv.

Comments: HOME NOT LOCATED AT TIME OF INSPECTION. KEEP IT MIN. OF 5' FROM SEPTIC SYSTEM.

INITIAL SITE SKETCH

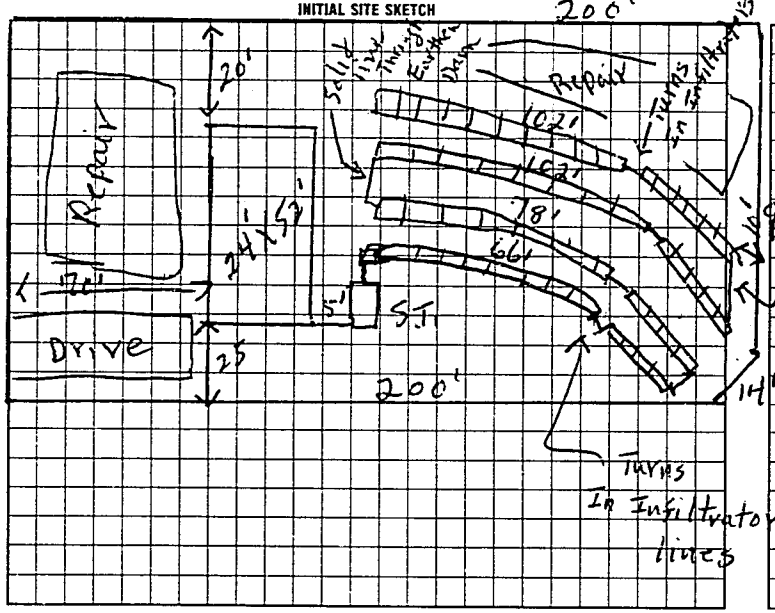

AS BUILT SKETCH

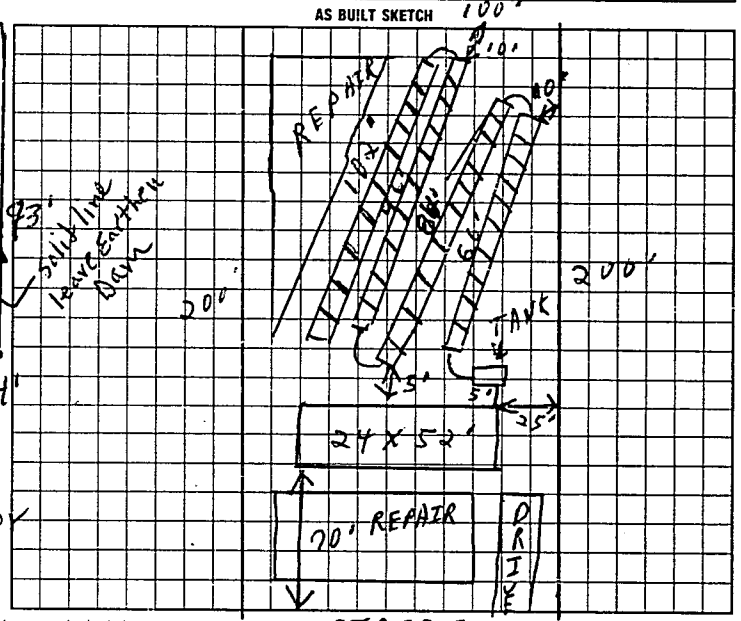

I understand that this permit can be suspended or revoked if any false information is supplied toward securing the permit/any unauthorized changes are made to the site/any ~~unauthorized~~ changes are made in the installation of the system.

Signed: X William Michael Holland Jr. Installed by: A-1 BACKHOE

Improvement Permit by: L.C. Moore date 11-15-95 Certificate of Completion by: _____ date _____

Existing System Inspection by: L.C. Moore date 11-15-95 Operation Permit by: Brad Stilliard / Michael X. Dennis date 12-22-95

HEALTH DEPT. COPY. WHITE INSPECTION COPY (FINAL) GREEN OWNER COPY (FINAL) YELLOW INSPECTION COPY (INITIAL) PINK OWNER COPY (INITIAL) GOLD

Authorization to const. Expires 6 months from date of issue

05 5000