IREDELL COUNTY HEALTH DEPARTMENT

STATESVILLE 704-878-5305 MOORESVILLE 704-664-5281

IMPROVEMENT PERMIT / AUTHORIZATION TO CONSTRUCT / OPERATION PERMIT / EXISTING SYSTEM INSPECTION

PERMIT# 092813 PIN# 4776 15 3769 DATE 2-28-01

OWNER OR CONTRACTOR ALMA SCOTT - MCCRAY PHONE: Business Home (704) 873-7649

ADDRESS 857 RIVER HILL ROAD, STATESVILLE, NC 28625

LOCATION US 64 EAST, TL RIVERHILL ROAD, HOUSE ON LEFT AT BOX #857

SUBDIVISION BLOCK / SECTION LOT LOT AREA 1.12 ACRES SITE CLASS PS DESIGN FLOW 360 L.T.A.R. 0.30 GPD/FT²

Septic Tank: 1000 Gallons: STB 1014 Date 4-15-01

Pump Tank: Gallons: PT Date

Pump Make: Model Serial No.

Nitrification Field: No Fields 1 Square Feet 1200 Linear Feet 400

No Lines THREE Trench Width 36" Max Trench Bottom Depth (36") Gravel Depth 12"

☒ New System ☐ Repair System Type: I (II) III IV V VI

System Description: CONVENTIONAL GRAVITY

Repair System Description: CONVENTIONAL PUMP

Maintenance Agreement Required: ☐ Yes ☒ No

☒ House/Mod. Home No. Bedrooms 3

☐ Mobile Home No. Bathrooms 2

☐ Business No. Employees

☐ Other ADDITION/3BR


☒ Slab ☐ Crawl Space ☐ Basement w/plumbing ☐ Basement w/o plumbing

Water Supply: ☒ Individual ☐ Public ☐ Community


Comments/Conditions: STUB-OUT PLUMBING SHALLOW TO ACCOMMODATE TRENCH DEPTHS OF 36 INCHES OR LESS (PUMP SYSTEM TO BE INSTALLED IF THESE DEPTHS CANNOT BE MET)

Comments/Conditions: 1500 GALON SEPTIC TANK W/ MARKED INSTALLED USING "POLYLOK" FILTER

INITIAL SITE SKETCH

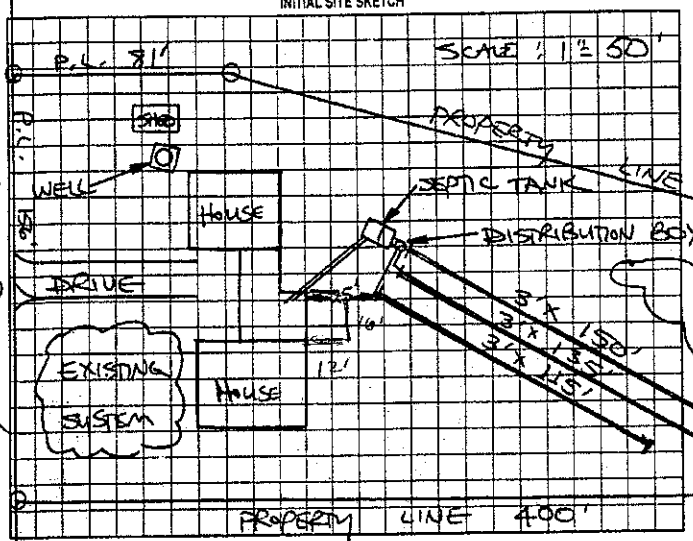

AS BUILT SKETCH

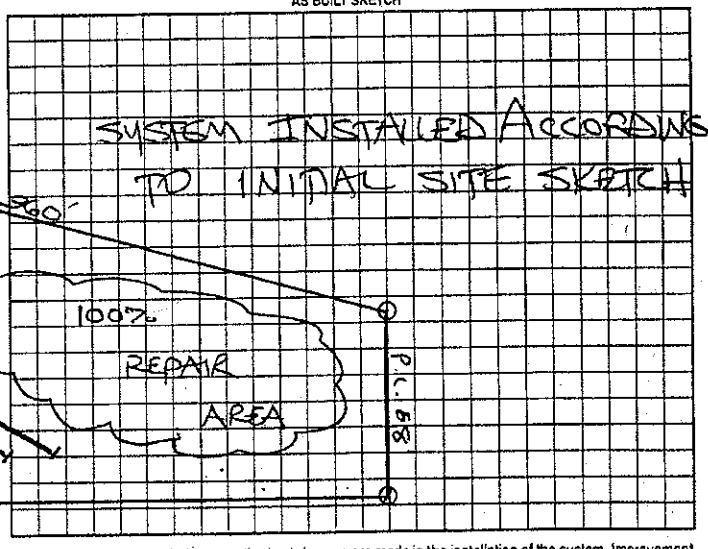

RIVERHILL ROAD (SR 2166)

Permit can be suspended or revoked if any false information is supplied toward securing the permit/any unauthorized changes are made to the site/any unauthorized changes are made in the installation of the system. Improvement Permit with plat valid without expiration. Improvement Permit with site plan valid for sixty months. Authorization to Construct is valid for a period equal to that of Improvement Permit – not to exceed sixty months.

Signed: Alfred Jones date

Improvement Permit by: STEVE HEDRICK date 2-28-01

Authorization to Construct by: STEVE HEDRICK date 2-28-01

Installed by: ROWAN SEPTIC TANK

Operation Permit by: STEVE HEDRICK date 5-15-01

Existing System Inspection by: date

HEALTH DEPT. COPY WHITE OWNER COPY (FINAL) YELLOW OWNER COPY (INITIAL) PINK

The location of the proposed porch (12'x16') addition does not appear to impact the existing septic system.

**NOTE:

REHS

Date: 9-20-10

ICHD-Environmental Health Division