IREDELL COUNTY HEALTH DEPARTMENT

Statesville Phone TR 3-7271 Mooresville Phone No. 664-5281

PERMIT TO INSTALL SEPTIC TANK

Permit No. 11 Permit Date 10-18 1972

Owner Bldr- NELSON BROWN Address STATESVILLE, NC

Installed By Bud HOKE - ARC RENTAL Address STATESVILLE, NC

Location of Property RIVER HILL Rd -


RIVER HILL HEIGHTS - LOT. #24

Tank		Capacity		Length of Lines		Fixtures	
Block	( )	1000	(✓)	225'	( )	No. of Baths	(1)
Precast	(✓)	1250	( )	250'	( )	Dishwasher	( )
		1500	( )	Other 300		Garbage Grdr.	( )
		Other		900 sq ft.		Other	

NOTIFY HEALTH DEPARTMENT AT LEAST EIGHT HOURS BEFORE TANK IS TO BE INSPECTED.

Final Inspection 10-18 1972 Approved (✓) Disapprcved ( )

Remarks Community WATER SUPPLY

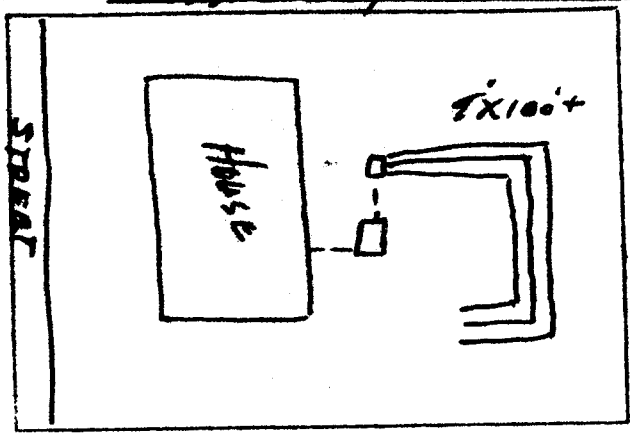

Sketch of Installation

Sanitarian