IREDELL COUNTY HEALTH DEPARTMENT

STATESVILLE 704-878-5305 MOORESVILLE 704-664-5281

IMPROVEMENT PERMIT / CERTIFICATE OF COMPLETION / OPERATION PERMIT / EXISTING SYSTEM INSPECTION

PROPERTY DESCRIPTION NO. 70513 DATE 12-9-97 TAX MAP NO. 4776156175 PT Watershed: ☐ Yes ☐ No

OWNER OR CONTRACTOR Khamphanh Chanthaboury PHONE: Business _____ Home 878 0586

ADDRESS 474 Old Mocksville Rd Statesville

LOCATION 64E TL Riverhall Rd past Chestnut Grove Rd TR Luangthep Lane Rt

SUBDIVISION _____ BLOCK / SECTION _____ LOT _____ LOT AREA 1 acres SITE CLASS. PS DESIGN FLOW 480 L.T.A.R. .3

Septic Tank: 1000 Gallons; STB 1012 Date 9-16-97

Pump Tank: _____ Gallons; PT _____ Date _____

Pump Make: _____ Model _____ Serial No. _____

Nitrification Field: No Fields 1 Square Feet 1600 Linear Feet 533

No Lines 5 Trench Width 36" Max Trench Bottom Depth 36" Gravel Depth 12"

☑ New System ☐ Repair System Type: I, (II) III, IV, V, VI

System Description: Conventional

Repair System Description: Gravity Chambers

Maintenance Agreement Required: ☐ Yes ☑ No

☐ House/Mod. Home No. Bedrooms 4

☑ Mobile Home No. Bathrooms 2

☐ Business No. Employees _____

☐ Other _____


☐ Slab ☑ Crawl Space ☐ Basement w/plumbing ☐ Basement wo/plumbing

Water Supply: ☐ Individual ☐ Community ☑ Public


Comments:

Comments:

INITIAL SITE SKETCH

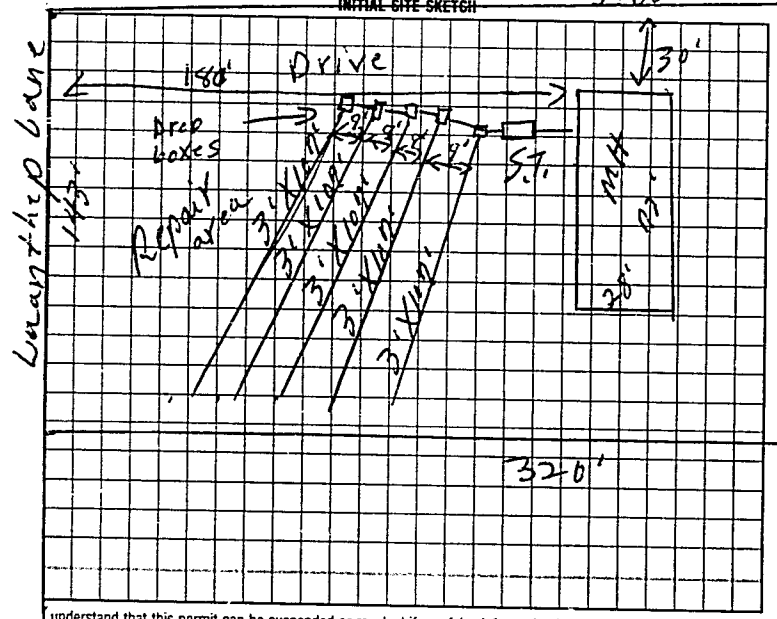

AS BUILT SKETCH

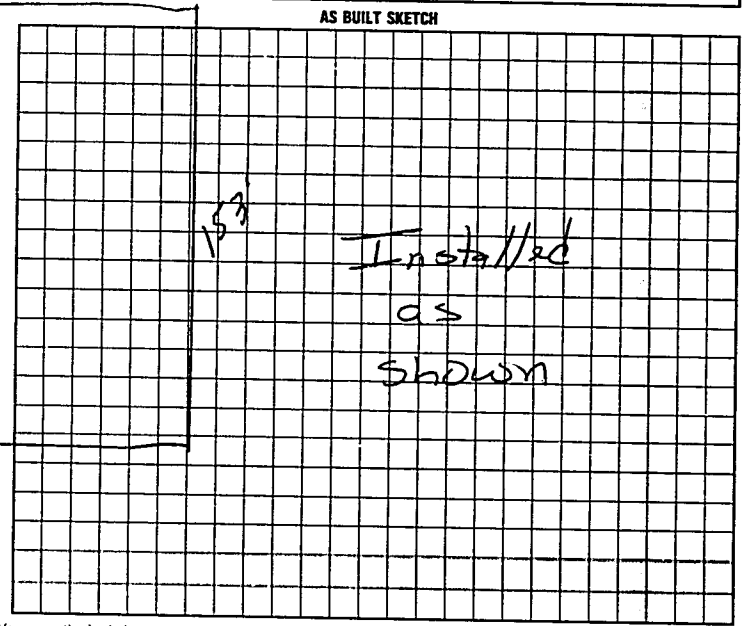

I understand that this permit can be suspended or revoked if any false information is supplied toward securing the permit/any unauthorized changes are made to the site/any unauthorized changes are made in the installation of the system. Improvement Permit is valid for 60 months from date of issuance.

Signed: x Khamphanh Chanthaboury

Improvement Permit by: L. C. Moore date 12-9-97

Authorization to Cont.

Existing System Inspection by L. C. Moore date 12-9-97

HEALTH DEPT. COPY: WHITE INSPECTION COPY (FINAL): GREEN

Installed by: A-1

Certificate of Completion by: _____ date _____

Operation Permit by Mark Cox PS date 12-23-97

OWNER COPY (FINAL): YELLOW INSPECTION COPY (INITIAL): PINK OWNER COPY (INITIAL): GOLD

Authorization to Cont. EXPIRED 6 months from issue