IREDELL COUNTY HEALTH DEPARTMENT

STATESVILLE 704-878-5305 MOORESVILLE 704-664-5281

IMPROVEMENT PERMIT / CERTIFICATE OF COMPLETION / OPERATION PERMIT / EXISTING SYSTEM INSPECTION

PROPERTY DESCRIPTION NO. 67866 DATE 7-14-97 TAX MAP NO. 4776 15 9216 Watershed: ☐ Yes ☑ No

OWNER OR CONTRACTOR Souphavek Luangthep PHONE: Business _____ Home _____

ADDRESS 114 Souphavek Lane

LOCATION 64E TR Riverhill Rd past Chestnut Grove Rd TR Souphavek Lane on Rt

SUBDIVISION Clover Downs BLOCK / SECTION _____ LOT 20 LOT AREA 3.54acres SITE CLASS. PS DESIGN FLOW 360 L.T.A.R. .3

Septic Tank: 1000 Gallons; STB 1012 Date 5-15-97

Pump Tank: _____ Gallons; PT _____ Date _____

Pump Make: _____ Model _____ Serial No. _____

Nitrification Field: No Fields 1 Square Feet 1200 Linear Feet 400

No Lines 3 Trench Width 36" Max Trench Bottom Depth 36" Gravel Depth 12"

☑ New System ☐ Repair System Type: I, II, III, IV, V, VI

System Description: Conv. Gravity

Repair System Description: " "

Maintenance Agreement Required: ☐ Yes ☐ No

☐ House/Mod. Home ☑ Mobile Home ☐ Business ☐ Other

No. Bedrooms 3 No. Bathrooms 2 No. Employees _____


☐ Slab ☑ Crawl Space ☐ Basement w/plumbing ☐ Basement wo/plumbing

Water Supply: ☐ Individual ☐ Community ☑ Public

Comments:

Comments: + Tank location moved slightly

INITIAL SITE SKETCH

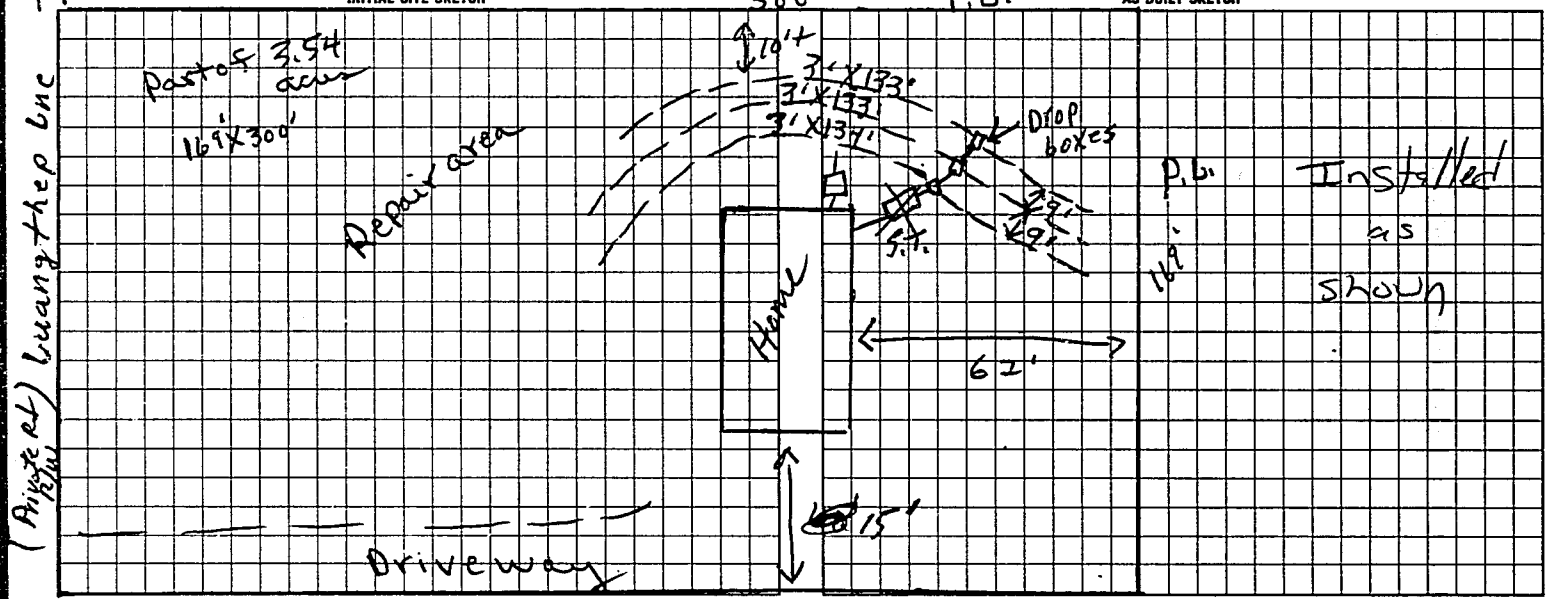

AS BUILT SKETCH

I understand that this permit can be suspended or revoked if any false information is supplied toward securing the permit/any unauthorized changes are made to the site/any unauthorized changes are made in the installation of the system. Improvement Permit is valid for 60 months from date of issuance.

Signed: Souphavack Luangthep

Improvement Permit by: R.C. Moore date 7-14-97

Existing System Inspection by: R.C. Moore date 7-14-97

Authorization to cover

Installed by: A-1 Backhoe

Certificate of Completion by: _____ date _____

Operation Permit by: Mat Conners date 7-24-97

Authorization to cover Expires 60 mos from issue

HEALTH DEPT. COPY WHITE INSPECTION COPY (FINAL) GREEN OWNER COPY (FINAL) YELLOW INSPECTION COPY (INITIAL) PINK OWNER COPY (INITIAL) GOLD

6 L 9 1 0 0