IREDELL COUNTY HEALTH DEPARTMENT

STATESVILLE 704-878-5305 MOORESVILLE 704-664-5281

IMPROVEMENT PERMIT / AUTHORIZATION TO CONSTRUCT / OPERATION PERMIT / EXISTING SYSTEM INSPECTION

PERMIT# 74219 PIN# 4776156175 DATE 7-20-98

OWNER OR CONTRACTOR Souphanak Luangthep PHONE: Business Home 871610

ADDRESS 114 Luangthep Ln Statesville, N.C.

LOCATION 64E TL Riverhill Rd TR Luangthep Ln at end left

SUBDIVISION Clover Downs BLOCK / SECTION LOT 20 LOT AREA .855 acres SITE CLASS. PS DESIGN FLOW 480 L.T.A.R. .33

Septic Tank: 1000 Gallons; STB 166 Date 6-25-98

Pump Tank: Gallons; PT Date

Pump Make: Model Serial No.

Nitrification Field: No Fields 1 Square Feet 1440 Linear Feet 480

No Lines 4 Trench Width 36" Max Trench Bottom Depth 36" Gravel Depth 12"

☑ New System ☐ Repair System Type: I, II, III, IV, V, VI

System Description: Conv. Gravity

Repair System Description: " "

Maintenance Agreement Required: ☐ Yes ☑ No

☐ House/Mod. Home ☑ Mobile Home ☐ Business ☐ Other

No. Bedrooms 4 No. Bathrooms 2 No. Employees


Water Supply: ☐ Individual ☑ Public ☐ Community

☐ Slab ☑ Crawl Space ☐ Basement w/plumbing ☐ Basement wo/plumbing


Comments:/Conditions:

Comments:/Conditions:

INITIAL SITE SKETCH

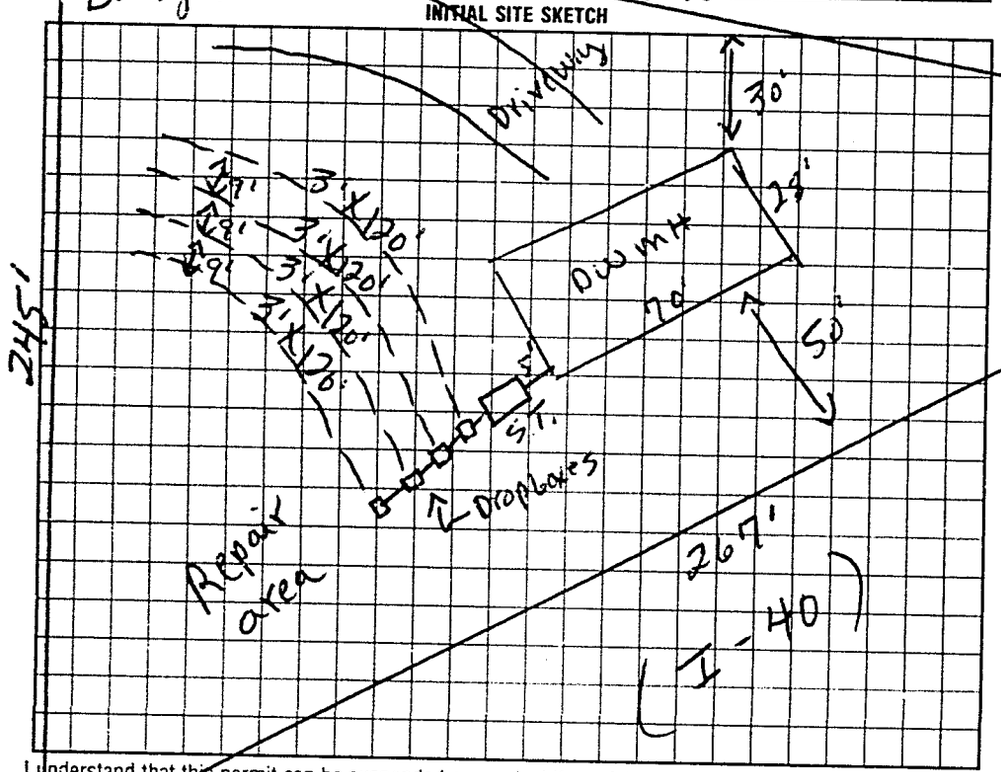

AS BUILT SKETCH

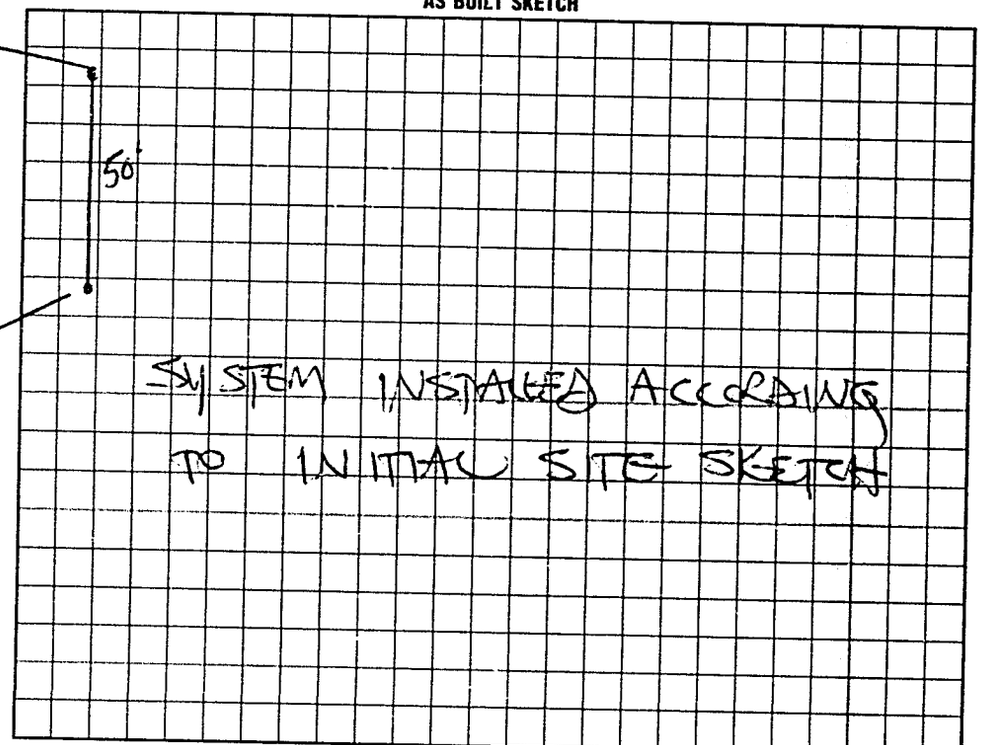

I understand that this permit can be suspended or revoked if any false information is supplied toward securing the permit/any unauthorized changes are made to the site/any unauthorized changes are made in the installation of the system. Improvement Permit with plat valid without expiration. Improvement Permit with site plan valid for sixty months. Authorization to Construct is valid for a period equal to that of Improvement Permit – not to exceed sixty months.

Signed: Souphanak Luangthep. date

Improvement Permit by: P.C. Moore date 7-20-98

Authorization to Construct by: P.C. Moore date 7-20-98

Installed by: SHANE WARRETT GRADING

Operation Permit by: STEVE HEARICK date 8-3-98

Existing System Inspection by: date

HEALTH DEPT. COPY: WHITE INSPECTION COPY (FINAL): GREEN OWNER COPY (FINAL): YELLOW INSPECTION COPY (INITIAL): PINK OWNER COPY (INITIAL): GOLD