9:36 60617

IREDELL COUNTY HEALTH DEPARTMENT

STATESVILLE 704-878-5305 MOORESVILLE 704-664-5281

IMPROVEMENT PERMIT / CERTIFICATE OF COMPLETION / OPERATION PERMIT / EXISTING SYSTEM INSPECTION

PROPERTY DESCRIPTION NO. 23794 DATE 5-9-96 TAX MAP NO. 11E-3-A-20pto5 Watershed: ☐ Yes ☒ No

OWNER OR CONTRACTOR Sourtsack Luangsthen PHONE: Business _____ Home 6636962

ADDRESS 810 S. main st. Mooresville N.C.

LOCATION 64E TL Riverhill Rd past Chestnut Grove Rd 1/4 mi Rt

SUBDIVISION Clover Downs BLOCK / SECTION _____ LOT 20-B LOT AREA 3 1/2 acres SITE CLASS. PS DESIGN FLOW 360 L.T.A.R. .32

Septic Tank: 1000 Gallons; STB 760 Date 2-25-96
Pump Tank: _____ Gallons; PT _____ Date _____
Pump Make: _____ Model _____ Serial No. _____
Nitrification Field: No Fields 1 Square Feet 1080 Linear Feet 360
No Lines 4 Trench Width 36" Max Trench Bottom Depth 36" Gravel Depth 12"

☐ New System ☐ Repair System Type: I, II, III, IV, V, VI
System Description: Conv. Gravity
Repair System Description: 11 11
Maintenance Agreement Required: ☐ Yes ☒ No


☐ House/Mod. Home No. Bedrooms 3
☒ Mobile Home No. Bathrooms 3
☐ Business No. Employees ____
☐ Other _____
☐ Slab ☒ Crawl Space ☐ Basement w/plumbing ☐ Basement wo/plumbing

Water Supply:
☐ Individual
☐ Community
☒ Public


Comments:

Comments:

INITIAL SITE SKETCH

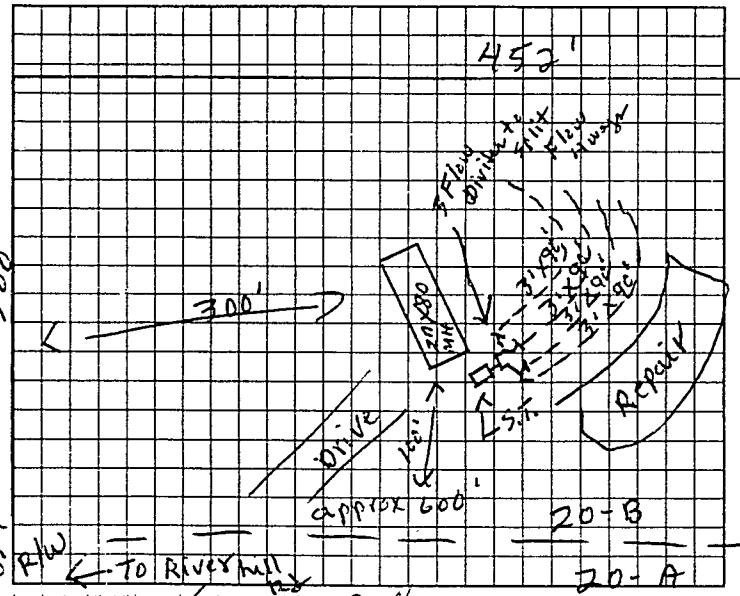

AS BUILT SKETCH

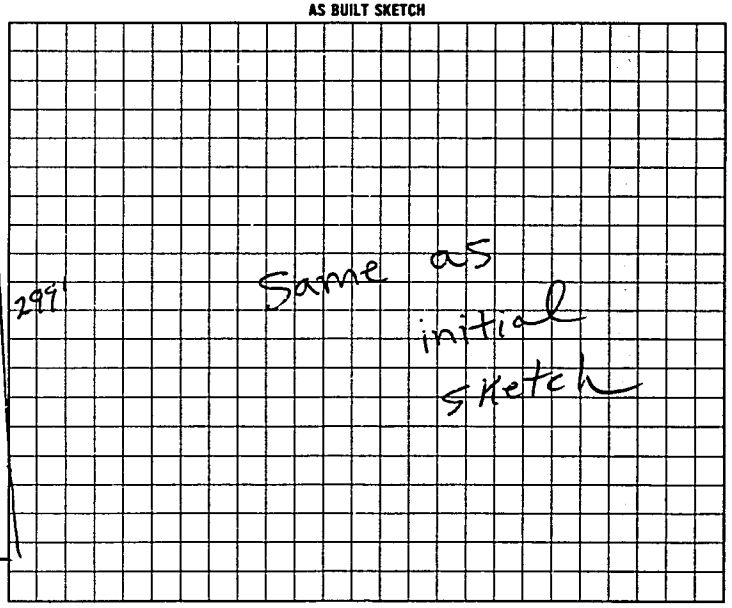

I understand that this permit can be suspended or revoked if any false information is supplied toward securing the permit/any unauthorized changes are made to the site/any unauthorized changes are made in the installation of the system.

Signed: X Sourtsack Luangsthen

Improvement Permit by: P. C. Moore date 5-9-96

~~Authorization~~ Existing System Inspection by: P. C. Moore date 5-9-96 to cover

Installed by: Randy miller

Certificate of Completion by: _____ date _____

Operation Permit by: P. C. Moore date 5-24-96

HEALTH DEPT COPY WHITE | INSPECTION COPY (FINAL) GREEN | OWNER COPY (FINAL) YELLOW | INSPECTION COPY (INITIAL) PINK | OWNER COPY (INITIAL) GOLD

Authorization to const. Expires 60 mos from issue

2122100