IREDELL COUNTY HEALTH DEPARTMENT

Statesville Phone TR 3-7271 Mooresville Phone NO 3-1271

PERMIT TO INSTALL SEPTIC TANK

Permit NO. _____ Permit Date Sept 30 19 67

Owner Victoria E Hoyle Address R 4

Installed By C Hoyle Address R 7


Location of Property River Hill #9 on left

| Tank | | Capacity | | Length of Lines | | Fixtures | |
|---|---|---|---|---|---|---|---|
| Block | ( ) | 1000 | (✓) | 225' | (✓) | No. of Baths | ( ) |
| Precast | (✓) | 1250 | ( ) | 250' | ( ) | Dishwasher | ( ) |
| Adams | | 1500 | ( ) | Other _____ | | Garbage Grdr. | ( ) |
| | | Other _____ | | | | Other Cinders | |

NOTIFY HEALTH DEPARTMENT AT LEAST EIGHT HOURS BEFORE TANK IS TO BE INSPECTED.

Final Inspection _____ 19__ Approved ( ) Disapproved ( )

Remarks No well this prop. Rocky - unable to cut full wide so added extra length & extra cinders

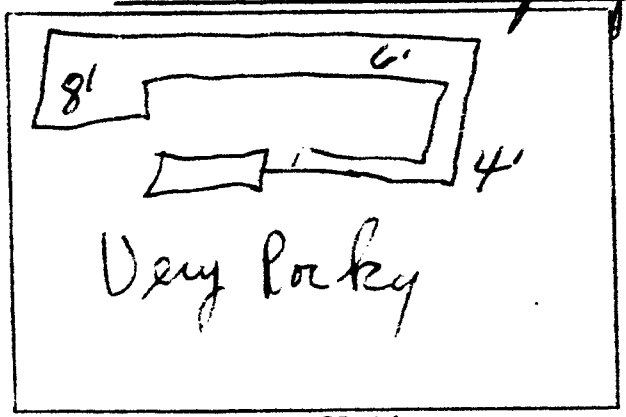


Sketch of Installation

R W J

Sanitarian