IREDELL COUNTY HEALTH DEPARTMENT

Statesville Phone TR 3-7271 Mooresville Phone NO 3-1271

PERMIT TO INSTALL SEPTIC TANK

Permit NO. _____ Permit Date Sept 30 19 67

Owner Hope & Hoyle Address RY

Installed By C Hoke Address R)


Location of Property River Hill #8 on left from paved Rd

Tank		Capacity		Length of Lines		Fixtures	
Block	( )	1000	( )	225'	( )	No. of Baths	( )
Precast	( )	1250	( )	250'	( )	Dishwasher	( )
		1500	( )	Other _____		Garbage Grdr.	( )
		Other _____				Other Trailer	

NOTIFY HEALTH DEPARTMENT AT LEAST EIGHT HOURS BEFORE TANK IS TO BE INSPECTED.

Final Inspection _____ 19___ Approved ( ) Disapproved ( )

Remarks No water this prop. Very very tight on base.

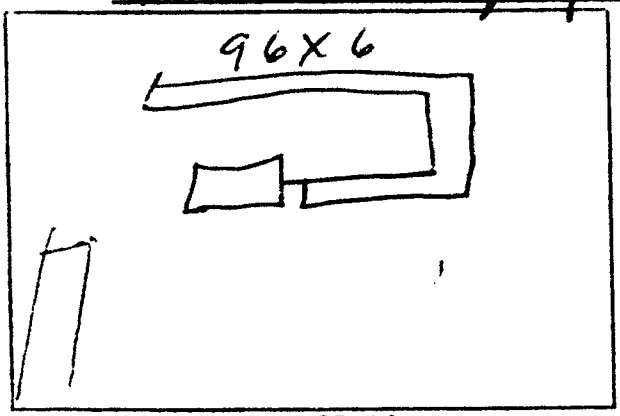

Sketch of Installation

Sanitarian