IREDELL COUNTY HEALTH DEPARTMENT

Statesville Office (704) 878-5305 Mooresville Office (704) 660-3625 PERMIT # 176812

IMPROVEMENT PERMIT / AUTHORIZATION TO CONSTRUCT / OPERATION PERMIT / EXISTING SYSTEM

PIN # 4776165539

APPLICANT: Debra M Sebastian APPLICANT ADDRESS: 809 Alexander St / Statesville

SITE ADDRESS: 143 Darty Lane PHONE: 704 872 3437 ALT. PHONE:


SITE DIRECTIONS: 64E; (L) River Hill Rd; (R) Darty Lane, site at end on left - dw

SUBDIVISION: n/a SECTION: LOT # 9 LOT AREA: .554 Acres DESIGN FLOW: 360 L.T.A.R.: .3


Septic Tank	1000	(gal)	STB	760	Date	12-13-12	[X] New System	[X] Repair	[ ] Expansion	System Type: I II (III) IV V VI	[X] Residence	No. Bedrooms	3	Water Supply
Pump Tank		(gal)	PT		Date		System Description:				[ ] Business	No. Persons		[X] Private
Pump Make			Model		Serial #		Repair System Description: 25% Reduction, Gravity				[ ] Other	No. Employees		[ ] Public
# Nitrification Fields	1		# Lines	4	Linear Ft:	200	Maintenance Agreement Required:	[ ] YES	[X] NO		[ ] Slab	[X] Crawl Space		[ ] Community
Trench Width	36"		Max. Trench Bottom Depth	36"	Gravel Depth	n/a	[X] GRAVITY	[ ] PRESSURE			[ ] Basement w/plumbing		[ ] Basement w/o plumbing	

Comments / Conditions:

INITIAL SITE SKETCH

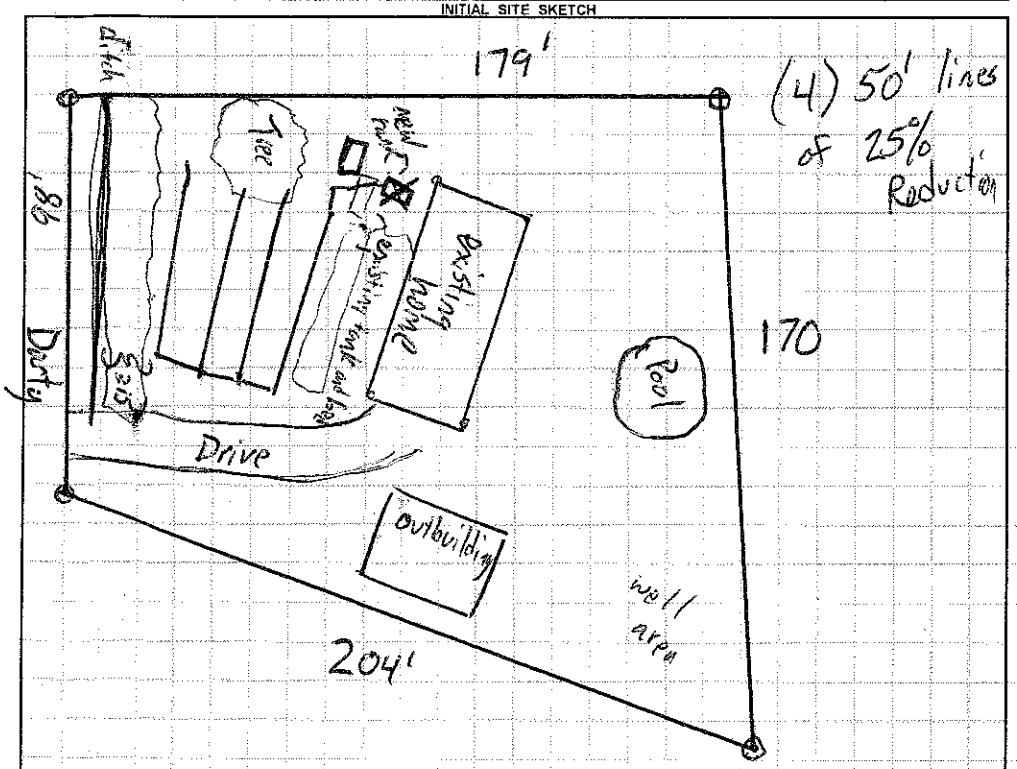

AS BUILT SKETCH

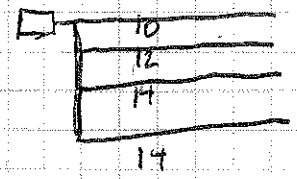

Permit can be suspended or revoked if any false information is supplied toward securing the permit / any unauthorized changes are made to the site / any unauthorized changes are made in the installation of the system. **CONTACT A LOCATOR SERVICE PRIOR TO ANY EXCAVATION**

[ ] **IMPROVEMENT PERMIT** ***with plat*** *valid without expiration.* [X] **IMPROVEMENT PERMIT** ***with site plan*** *valid for 60 mos.* [X] **AUTHORIZATION TO CONSTRUCT** *valid for period equal to IMPROVEMENT PERMIT--not to exceed 60 mo.*

Owner / Applicant Signature: Debra B. Sebastian Date: 4-16-13 Installed by: Cothren & Sons

IMPROVEMENT PERMIT by: Date: 4-16-13 OPERATION PERMIT by: Date: 4-19-13

AUTHORIZATION TO CONSTRUCT by: Date: 4-16-13 Existing System Inspected by: Date:

Health Dept. Copy - WHITE Applicant (Final Approval) - YELLOW Applicant (Conditional Approval) - PINK