IREDELL COUNTY HEALTH DEPARTMENT

Statesville Phone TR 3-7271 Mooresville Phone NO 3-1271

PERMIT TO INSTALL SEPTIC TANK

Permit NO. _____ Permit Date Sept 1967

Owner Hope & Bofouth Address R 1

Installed By C Hope Address R 7


Location of Property River Hill Rd trailer Park #2 on R.

Tank		Capacity		Length of Lines		Fixtures	
Block	( )	1000	( )	225'	( )	No. of Baths	( )
Precast	(✓)	1250	( )	250'	( )	Dishwasher	( )
		1500	( )	Other _____		Garbage Grdr.	( )
adams.		Other _____				Other _____	

NOTIFY HEALTH DEPARTMENT AT LEAST EIGHT HOURS BEFORE TANK IS TO BE INSPECTED.

Final Inspection _____ 19__ Approved ( ) Disapproved ( )

Remarks no well 50' of layout. water outlet 18" from S. Tank. dnstaler not liabe for any damage that may result from grading - landscaping or grade changes.

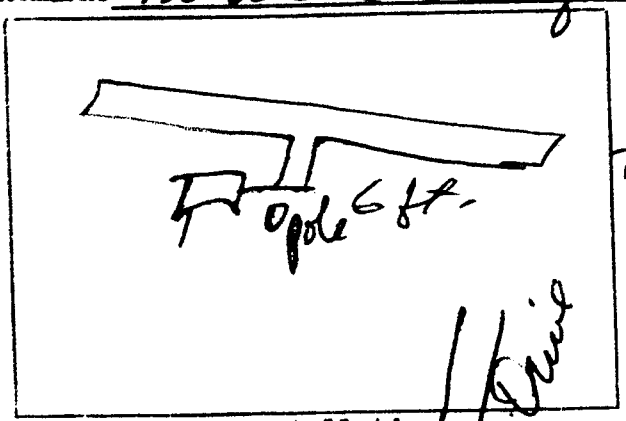

Sketch of Installation

R W J

Sanitarian