IREDELL COUNTY HEALTH DEPARTMENT

Statesville Phone TR 3-7271 Mooresville Phone NO 3-1271

PERMIT TO INSTALL SEPTIC TANK

Permit NO. _____ Permit Date Sept 1967

Owner Hope & Gaston Th. Address R 1

Installed By C Hoke Address R 7


Location of Property River Hill trailer lots #3 on R.

Tank		Capacity		Length of Lines		Fixtures	
Block	( )	1000	(✓)	225'	(✓)	No. of Baths	( )
Precast	(✓)	1250	( )	250'	( )	Dishwasher	( )
adams		1500	( )	Other _____		Garbage Grdr.	( )
		Other _____				Other trailer	

NOTIFY HEALTH DEPARTMENT AT LEAST EIGHT HOURS BEFORE TANK IS TO BE INSPECTED.

Final Inspection _____ 19__ Approved ( ) Disapproved ( )

Remarks no well w/in 50' layout

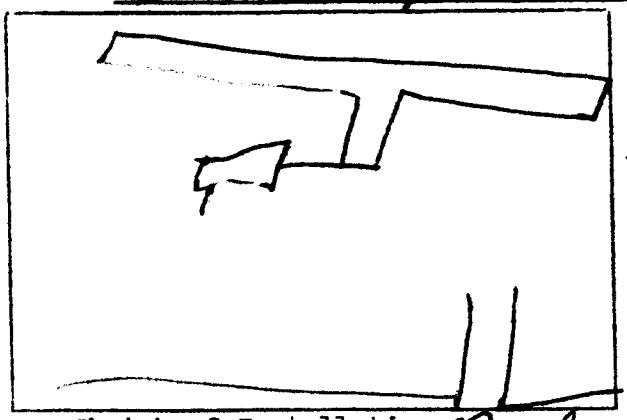

Sketch of Installation

water outlet 10ft from S/Tank - Contractor not liable any damages due to grade of yard work.

Sanitarian