IREDELL COUNTY HEALTH DEPARTMENT

Statesville Phone TR 3-7271 Mooresville Phone NO 3-1271

PERMIT TO INSTALL SEPTIC TANK

Permit NO. _____ Permit Date Sept 1969

Owner Hope & Gofath Address R4

Installed By C. Hoke Address R7


Location of Property River Hill Rd #4 on R

Tank		Capacity		Length of Lines		Fixtures	
Block	( )	1000	(✓)	225'	(✓)	No. of Baths	( )
Precast	(✓)	1250	( )	250'	( )	Dishwasher	( )
Adams		1500	( )	Other _____		Garbage Grdr.	( )
		Other _____				Other Trailer	

NOTIFY HEALTH DEPARTMENT AT LEAST EIGHT HOURS BEFORE TANK IS TO BE INSPECTED.

Final Inspection _____ 19__ Approved ( ) Disapproved ( )

Remarks No well on prop.

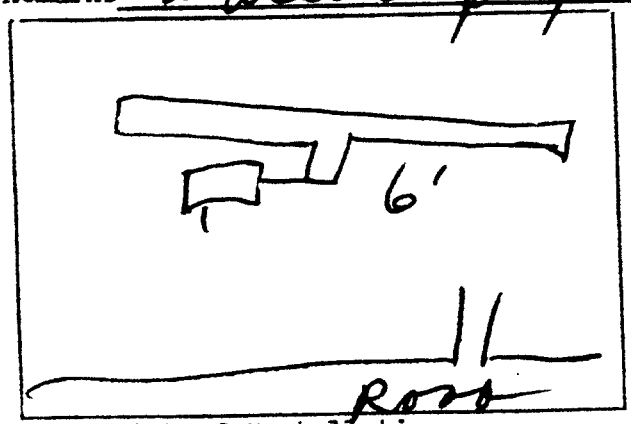

Sketch of Installation

Not liable for any damage due to yard work.

Sanitarian