IREDELL COUNTY HEALTH DEPARTMENT

Statesville Phone TR 3-7271 Mooresville Phone NO 3-1271

PERMIT TO INSTALL SEPTIC TANK

Permit NO. _____ Permit Date Sept 1967

Owner Hope E Goforth Address R 7 Sta.

Installed By C Hoke Address R 7

Location of Property River Hill Rd. trailer Park


#1 on R.

Tank		Capacity		Length of Lines		Fixtures	
Block	( )	1000	(✓)	225'	(✓)	No. of Baths	( )
Precast	(✓)	1250	( )	250'	( )	Dishwasher	( )
Adams.		1500	( )	Other _____		Garbage Grdr.	( )
		Other _____				Other trailer	

NOTIFY HEALTH DEPARTMENT AT LEAST EIGHT HOURS BEFORE TANK IS TO BE INSPECTED.

Final Inspection _____ 19__ Approved ( ) Disapproved ( )

Remarks no well with in 50' lay out water in let 10' from s/tank - Contractor not liable for any damage due to grading or landscaping or grade change

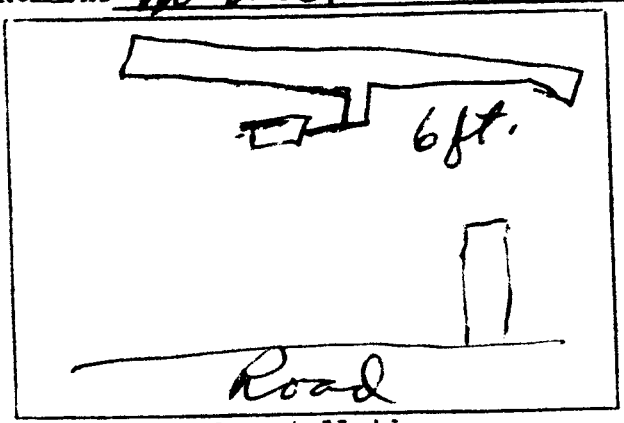

Sketch of Installation

Sanitarian