IREDELL COUNTY HEALTH DEPARTMENT

Statesville Phone TR 3-7271 Mooresville Phone NO 3-1271

PERMIT TO INSTALL SEPTIC TANK

Permit NO. Wesley Johnson Elder. Permit Date Aug 5 1968

Owner Dr. Benny Miller Address Chas. N.C.

Installed By C Hoke Address R7


Location of Property Lt. 4 Statesville - East of Chestnut grove sch. left onto 2168 dirt go 3 miles cross creek on left. Summer home

Tank		Capacity		Length of Lines		Fixtures	
Block	( )	1000	(✓)	225'	(✓)	No. of Baths	(2)
Precast	(✓)	1250	( )	250'	( )	Dishwasher	( )
Lock		1500	( )	Other		Garbage Grdr.	( )
		Other				Other	

NOTIFY HEALTH DEPARTMENT AT LEAST EIGHT HOURS BEFORE TANK IS TO BE INSPECTED.

Final Inspection 19 Approved ( ) Disapproved ( )

Remarks Light working cond. soil not too good.

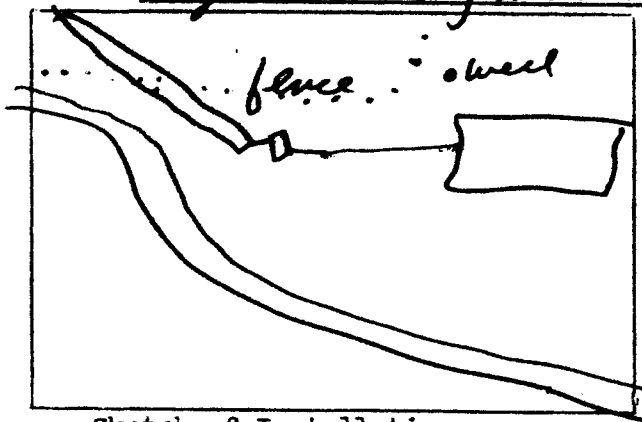

well 500 drain lines out old road bed

Sketch of Installation

Sanitarian