IREDELL COUNTY HEALTH DEPARTMENT

STATESVILLE 704-878-5305 MOORESVILLE 704-664-5281

IMPROVEMENT PERMIT / CERTIFICATE OF COMPLETION / OPERATION PERMIT / EXISTING SYSTEM INSPECTION

PROPERTY DESCRIPTION NO. 16337 DATE 6-11-93 TAX MAP NO. 1 E-3-A-19

OWNER OR CONTRACTOR Jerry Campbell PHONE: Business Home 878-9213

ADDRESS 325 S. Race Statesville

LOCATION 64 I to Riverhill Rd past Darty Home TR private Rd Use Gate out in Field

SUBDIVISION Clover Downs BLOCK / SECTION LOT 19 LOT AREA 3.3 SITE CLASS PS L.T.A.R. .4

Water Supply: ☐ Individual ☐ Community ☑ Public

Septic Tank: 1250 Gallons; STB 1012 Date 9/28/94

Pump Tank: Gallons; PT Date

Nitrification Field: No Fields 1 Square Feet 1200 Linear Feet 400

No Lines 3 Trench Width 36 Trench Depth 24 Gravel Depth 12

☑ New System ☐ Repair System Type: I (II) III, IV, V, VI

System Description: Conv. Gravity

Repair System Description:

Maintenance Agreement Required: ☐ Yes ☑ No

☑ House/Mod. Home ☐ Mobile Home ☐ Business ☐ Other

No. Bedrooms 4 No. Bathrooms 3 No. Employees

☐ Slab ☐ Crawl Space ☑ Basement w/plumbing ☐ Basement wo/plumbing

Garbage Disposal: ☐ Yes ☑ No


Auto. Dishwasher: ☑ Yes ☐ No

Auto. Washing Machine: ☑ Yes ☐ No


Other

Comments

INITIAL SITE SKETCH

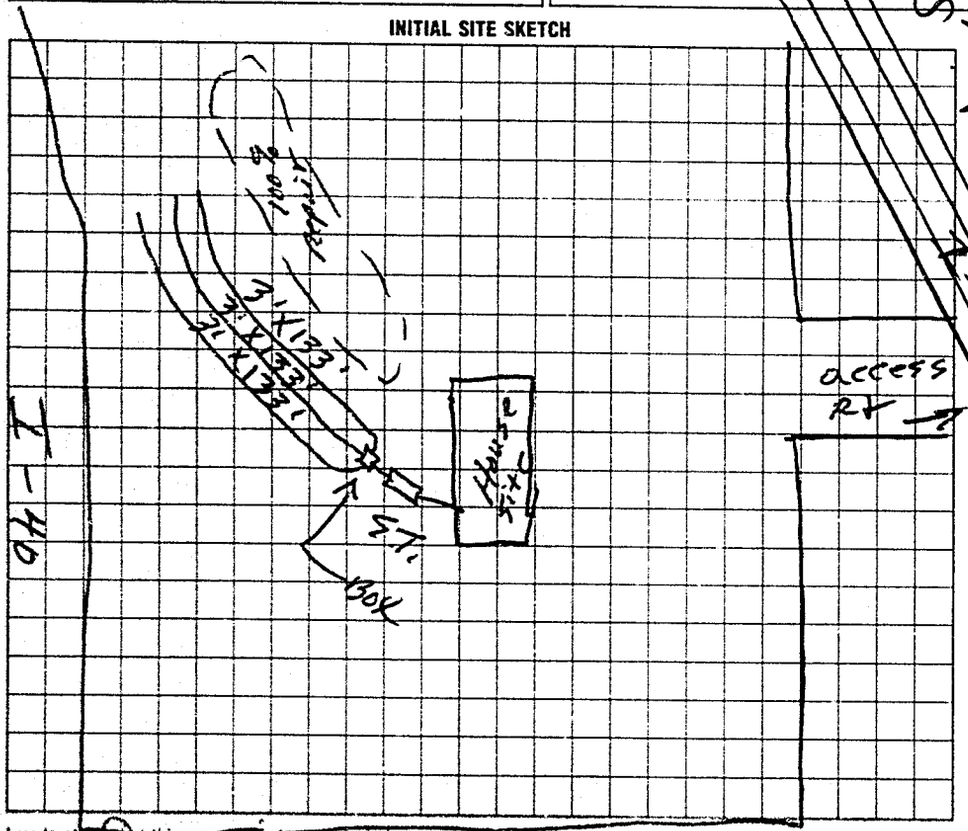

AS BUILT SKETCH

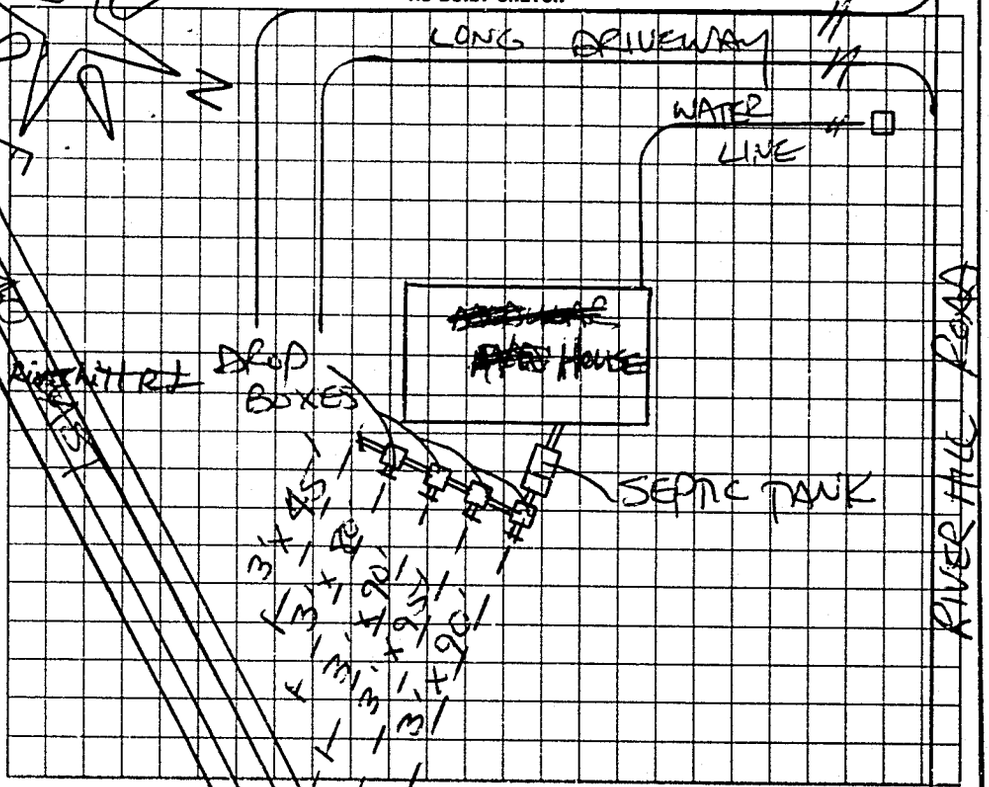

I understand that this permit can be suspended or revoked if any false information is supplied toward securing the permit/any unauthorized changes are made to the site/any unauthorized changes are made in the installation of the system. Improvement Permit is valid for 60 months from date of issuance.

Signed: Jerry W. Campbell

Improvement Permit by: L. C. Moore date

Existing System Inspection by: date

Installed by: Donald Lackey

Certificate of Completion by: Steve Herrick date 12/29/94

Operation Permit by: date

HEALTH DEPT. COPY: WHITE INSPECTION COPY (FINAL): GREEN OWNER COPY (FINAL): YELLOW INSPECTION COPY (INITIAL): PINK OWNER COPY (INITIAL): GOLD