IREDELL COUNTY HEALTH DEPARTMENT

Statesville Office (704) 878-5305 Mooresville Office (704) 660-3625 PERMIT # 212078

IMPROVEMENT PERMIT / AUTHORIZATION TO CONSTRUCT / OPERATION PERMIT / EXISTING SYSTEM

PIN # 4776267175

APPLICANT: Abee's Clearing + Grading APPLICANT ADDRESS: 2381 US Hwy 64 W

SITE ADDRESS: 931 River Hill Rd. PHONE: 828-234-3981 ALT. PHONE: N/A

SITE DIRECTIONS: Hwy 64 E TL River Hill Rd ~ 3miles on Left

SUBDIVISION: Clover Downs SECTION: N/A LOT # 2 LOT AREA: 0.47acres DESIGN FLOW: 360gpd L.T.A.R.: 0.25

Septic Tank 1000 (gal) STB 760-1000 Date 4-22

Pump Tank (gal) PT Date

Pump Make Model Serial #

Nitrification Fields 1 # Lines Existing + 2 Linear Ft: 128

Trench Width 36" Max. Trench Bottom Depth 36" Gravel Depth N/A

☐ New System ☐ Repair ☑ Expansion System Type: I II (III) IV V VI

System Description: 25% Reduction

Repair System Description: 25% Reduction

Maintenance Agreement Required: ☐ YES ☑ NO

☑ GRAVITY ☐ PRESSURE

☑ Residence No. Bedrooms 3

☐ Business No. Persons 6

☐ Other No. Employees


☐ Slab ☑ Crawl Space

☐ Basement w/plumbing ☐ Basement w/o plumbing

Water Supply: ☐ Private ☑ Public ☐ Community

Comments / Conditions: - Pump + crush existing septic tank. Cut off existing drainfield lines 10' from property line + install drop boxes on each line as shown below. Install 2 New 25% Reduction lines @ location shown below + feed entire system via serial distribution

INITIAL SITE SKETCH

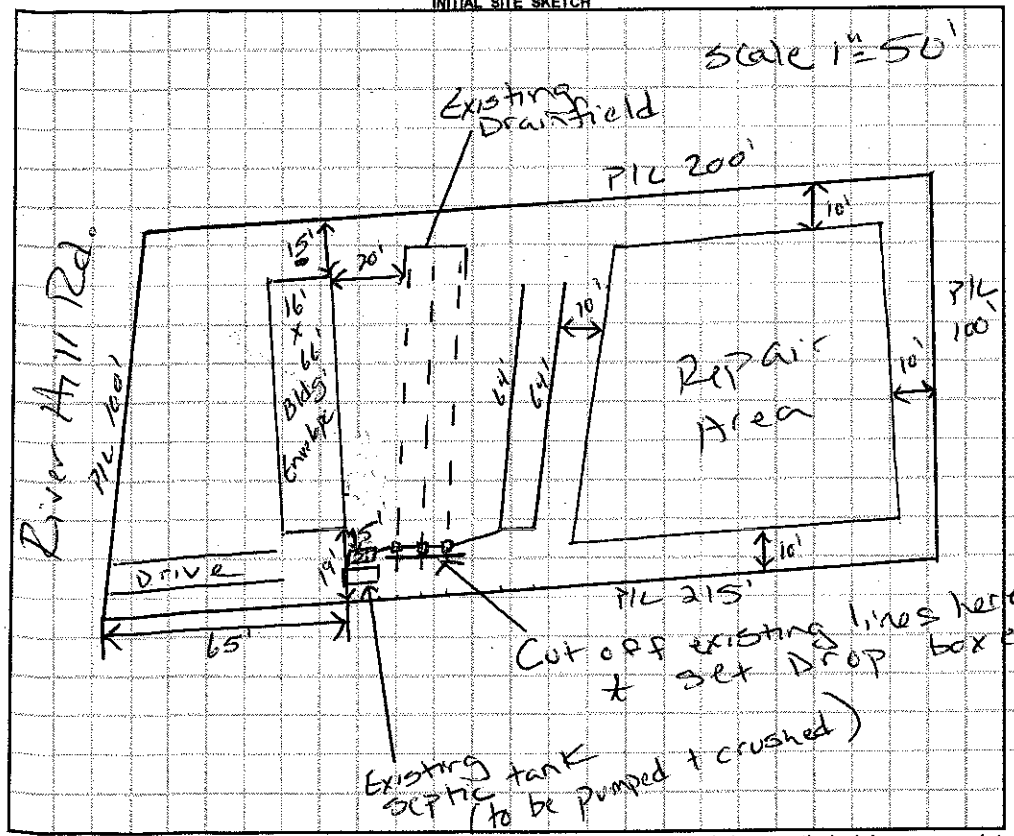

AS BUILT SKETCH

- Quick 4 Chambers installed
- Installed as drawn

Permit can be suspended or revoked if any false information is supplied toward securing the permit / any unauthorized changes are made to the site / any unauthorized changes are made in the installation of the system. CONTACT A LOCATOR SERVICE PRIOR TO ANY EXCAVATION

☐ IMPROVEMENT PERMIT *with plat* valid without expiration. ☑ IMPROVEMENT PERMIT *with site plan* valid for 60 mos. ☑ AUTHORIZATION TO CONSTRUCT valid for period equal to IMPROVEMENT PERMIT--not to exceed 60 mo.

Owner / Applicant Signature: Rick Marsh Date: 8-4-15 Installed by: Al-Backhoe

IMPROVEMENT PERMIT by: Justin Henderson Date: 8.4.15 OPERATION PERMIT by: Justin Henderson Date: 8-7-15

AUTHORIZATION TO CONSTRUCT by: Justin Henderson Date: 8.4.15 Existing System Inspected by: Date:

Health Dept. Copy - WHITE Applicant (Final Approval) - YELLOW Applicant (Conditional Approval) - PINK