IREDELL COUNTY HEALTH DEPARTMENT

STATESVILLE 704-878-5305 MOORESVILLE 704-664-5281

IMPROVEMENT PERMIT / CERTIFICATE OF COMPLETION / OPERATION PERMIT / EXISTING SYSTEM INSPECTION

PROPERTY DESCRIPTION NO. 16508 DATE 6-15-93 TAX MAP NO. 11E-3-A-2

OWNER OR CONTRACTOR Olde Towne mobile Homes PHONE: Business 873-1471 Home

ADDRESS 2016 N. Side Drive Statesville

LOCATION 64E TO Riverhill Rd past Dairy Lane 1/4 mi on left SITE CLASS. PS L.T.A.R. .34

SUBDIVISION Clover Downs BLOCK / SECTION LOT 2 LOT AREA 100 X 200

Water Supply: ☐ Individual ☐ Community ☑ Public

Septic Tank: 1000 Gallons; STB 358 Date 4-27-93

Pump Tank: Gallons; PT Date

Nitrification Field: No Fields 1 Square Feet 720 Linear Feet 240

No Lines 3 Trench Width 36 Trench Depth 24 Gravel Depth 12

☐ New System ☐ Repair System Type: I, II, IV, V, VI

System Description: Conv. Gravity

Repair System Description:

Maintenance Agreement Required: ☐ Yes ☐ No

☐ House/Mod. Home ☑ Mobile Home ☐ Business ☐ Other

No. Bedrooms 2 No. Bathrooms 1 3/4 No. Employees

☐ Slab ☑ Crawl Space ☐ Basement w/plumbing ☐ Basement wo/plumbing

Garbage Disposal: ☐ Yes ☑ No


Auto. Dishwasher: ☐ Yes ☑ No

Auto. Washing Machine: ☑ Yes ☐ No

Other

Comments

INITIAL SITE SKETCH

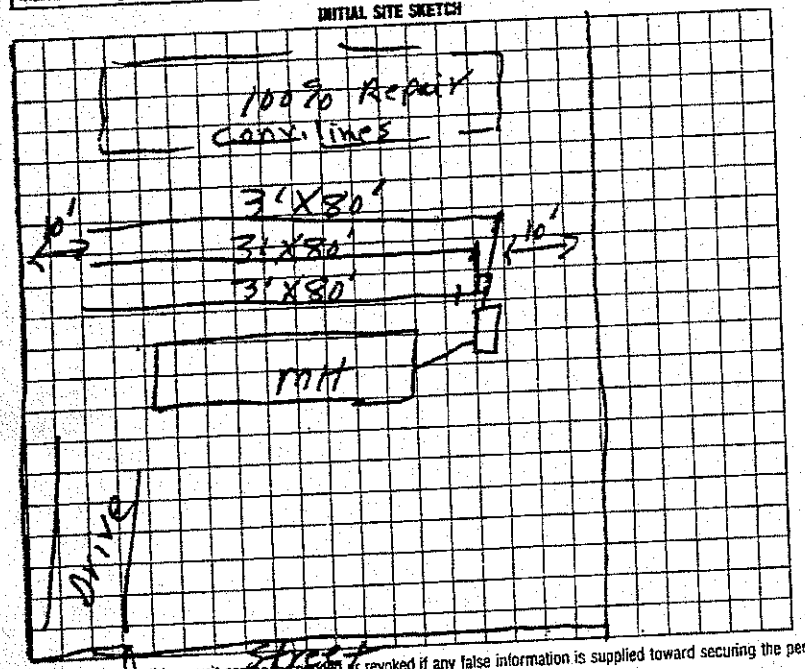

AS BUILT SKETCH

Same as initial sketch

I understand that this permit can be suspended or revoked if any false information is supplied toward securing the permit/any unauthorized changes are made to the site/any unauthorized changes are made in the installation of the system. Improvement Permit is valid for 60 months from date of issuance.

Signed: date

Improvement Permit by: E. C. Moore date 6-15-93

Existing System Inspection by: date

Installed by: A-1 Backhoe

Certificate of Completion by: E. C. Moore date 6-17-93

Operation Permit by: date

HEALTH DEPT. COPY: WHITE INSPECTION COPY (FINAL): GREEN OWNER COPY (FINAL): YELLOW INSPECTION COPY (INITIAL): PINK OWNER COPY (INITIAL): GOLD