IREDELL COUNTY HEALTH DEPARTMENT *ENVIRONMENTAL HEALTH DIVISION*

Application for SEPTIC REPAIR PERMIT

(THE ABOVE PERMIT DOCUMENTS WILL BECOME INVALID IF INFORMATION PROVIDED ON THIS APPLICATION IS FALSIFIED OR CHANGED, OR IF THE SITE IS ALTERED. THE IMPROVEMENT PERMIT IS VALID FOR EITHER 60 MONTHS OR WITHOUT EXPIRATION DEPENDING UPON DOCUMENTATION SUBMITTED - APPLICATION WITH SITE PLAN 60 MONTHS, APPLICATION WITH COMPLETE, SCALED PLAT WITHOUT EXPIRATION. SEE 15A NCAC 18A .1937(f) FOR DETAILS)

1. APPLICATION FOR: ___Improvement Permit ___Authorization To Construct ___ BOTH ✓ Existing System Inspection

2. Page 2: *Site Plan Worksheet* Form MUST Accompany This Application
The following optional attachments may also be submitted: ___Survey Plat, Scaled no more than 1 Inch = 60 Feet
✓ Custom Site Plan, Scaled no more than 1 Inch = 60 Feet
Place check ( ) beside whichever is submitted if applicable

3. **Applicant Information:**

Applicant Name	Mailing Address	Home Phone #	Alternate Phone #
Rick Marsh	149 Seven Springs Lp. Stvl	704-876-4023	704-239-3693
Owner Name: same	Mailing Address	Home Phone #	Alternate Phone #

Deena

4. **Property Information:**

River Hill Rd (Street Address) — Clover Downs (Subdivision Name) — Lot 2 (Section/Phase and Lot Number)

Driving Directions: 64E - ⓛ River Hill Rd - approx 3.3 miles - property on left - beside #935.

5. **RESIDENTIAL Site Development Information:** *(Check or Complete ALL that apply)*

(✓) New, Single Family Residence
( ) New, Multi-Family Residence
( ) Expansion of Existing Septic System
(X) Repair To Failing Septic System due to _____
( ) Other _____

Maximum Number of Bedrooms 3
Maximum Number of Occupants 2
If Expansion, Current Number of Bedrooms ___

(✓) Crawl Space Foundation?
( ) Concrete Slab Foundation?
( ) Basement w/Plumbing?
( ) Basement w/out Plumbing?

If Non-Residential Site Development: Type of Business ___ Square Footage of Building ___ Maximum Number of Employees ___ Maximum Number of Seats ___

6. **Proposed Water Supply:**

( ) New Well ( ) Existing Well ( ) Community Well ( ) City Water ✓) Other Public Water

7. **Desired Septic System Type:** *(You may rank in order of preference, if any)* ( ) EXISTING SYSTEM installed ____ *Year*

( ) Alternative ( ) Conventional ( ) Innovative ( ) Modified Conventional ( ) Other_____

8. Please Answer The Following ( ) Yes ( ) No Does the site contain any jurisdictional wetlands?
To The Best of Your Ability: ( ) Yes ( ) No Is any non-domestic sewage (i.e. industry) to be generated?
( ) Yes ( ) No Is the site subject to approval by any other public agency?

I have read this application and certify that the information provided herein is true, complete, and correct. Authorized county and state officials are granted right of entry to conduct necessary inspections to determine compliance with applicable laws and rules. I understand that I am solely responsible for the proper identification and labeling of all property lines and corners and making the site accessible so that a complete site evaluation can be performed.

9. Signature: Deena Reed — 2/16/15
Property owner or owner's legal representative signature (SIGNATURE REQUIRED) — DATE

IREDELL COUNTY HEALTH DEPARTMENT *ENVIRONMENTAL HEALTH DIVISION :*

SITE PLAN WORKSHEET

SEE THE "SAMPLE SITE PLAN" BELOW. *INCOMPLETE SITE PLANS WILL BE RETURNED TO YOU FOR COMPLETION AND MAY RESULT IN A DELAY IN THE ISSUANCE OF YOUR SEPTIC SYSTEM PERMIT!!!*

Place an (X) beside each item as you complete the site plan:

✓ Property Line measurements are clearly identified...

✓ All proposed structures are indicated...

SHOW: proposed house or business footprint, wells, water lines, patios, pools and decks, and any other item that will occupy space on the site

____ Front and side setbacks from property line...

____ Area you prefer your septic system to be placed...

____ Preferred driveway location and configuration, preferred well location...


____ North arrow, or other sufficient indicator of direction...

Circle N/A on the following if appropriate:


____ Location of septic systems and wells within 100' of your property... N/A

____ Location of easements and rights of ways on your property... N/A

____ Location of any designated wetlands on the property... N/A

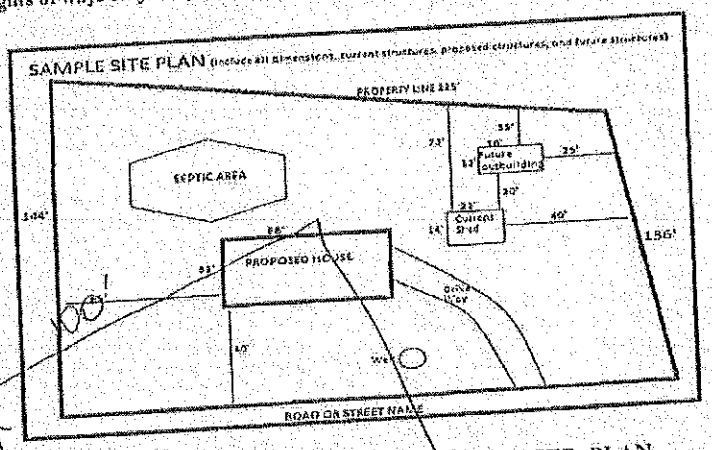

USE THIS SPACE TO DRAW YOUR SITE PLAN

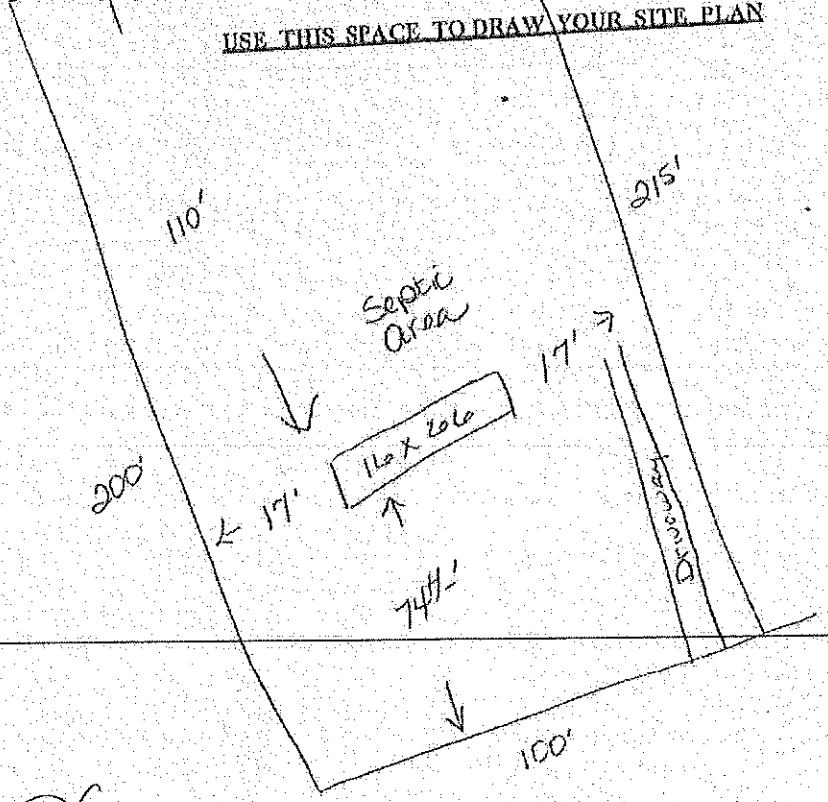

Signature: Debra Allen
REQUIRED property owner or owner's legal representative signature.

7/14/15
DATE

IREDELL COUNTY DEPARTMENT OF ENVIRONMENTAL HEALTH

DOCUMENTATION TO AUTHORIZE AN OWNER'S LEGAL REPRESENTATIVE

Applications for permits require the "signature of the owner or owner's legal representative" (15A NCAC 18A .1937). If the owner does not sign the application himself or herself, they can submit any one of the following documents to designate their legal representative:

Power of Attorney; Real Estate Contract; Estate executor; Bankruptcy trustee; Court ordered guardianship

In the absence of the above documentation, the property owner may provide the local health department with documentation that designates a legal representative. A property owner may:

Complete this form to document his or her legal representative, or provide his or her own form that contains the information in this form.

If there are multiple property owners, then all property owners must sign the form that designates a legal representative.

By signing a form that designates a legal representative for purposes of 15A NCAC 18A .1937, the property owner authorizes that representative to act on their behalf in matters pertaining to the application and permitting process, including signing or receiving any application, document or permit. The owner retains full responsibility to meet all permit conditions specified by the local health department.

I, Ricky Marsh, am the legal owner(s) of the property located at River Hill Rd., identified as PIN (Parcel Identification Number) 4776916175, located in Iredell County, North Carolina.

I do hereby authorize **(print legal representative/company name)** Deena Abee, to act as an agent on my behalf in applying for/signing/obtaining any of the documents described below.

- Application for Improvement Permit (IP) / Authorization to Construct (AC)
- Improvement Permit (IP) / Authorization to Construct (AC)
- Application for soil-site evaluation (new/repair)
- Application/permit for private drinking water well/well abandonment
- Application for Compliance Inspection

I agree to abide by all decisions and/or conditions between the legal representative acting on my behalf and the Iredell County Department of Public Health, Environmental Health Division.

Signature of Owner(s) — Date 7/14/15

Signature of Witness — Date 7/14/15

Please return this signed form to the appropriate office:

Mooresville - Environmental Health
ronda.hart@co.iredell.nc.us
Fax: 704-662-3239
610 E. Center Avenue, Mooresville, NC 28115

Statesville - Environmental Health
adrienne.shea@co.iredell.nc.us
Fax: 704-871-3483
349 N. Center Street, Statesville, NC 28677

IREDELL COUNTY HEALTH DEPARTMENT

STATESVILLE 704-878-5305 MOORESVILLE 704-664-5281

IMPROVEMENT PERMIT / CERTIFICATE OF COMPLETION / OPERATION PERMIT / EXISTING SYSTEM INSPECTION

PROPERTY DESCRIPTION NO. 16508 DATE 6-15-93 TAX MAP NO. 11E-3-A-2

OWNER OR CONTRACTOR Olde Towne mobile Homes PHONE: Business 873-1481 Home

ADDRESS 2016 N. Side Drive Statesville

LOCATION 64E TL Riverhill Rd past Barty Lane 1/8 mi on L-st

SUBDIVISION Clover Downs BLOCK / SECTION LOT 2 LOT AREA 100 X 200 SITE CLASS P3 L.T.A.R. .34

Water Supply: ☐ Individual ☐ Community ☑ Public

Septic Tank: 1000 Gallons; STB 358 Date 4-27-93

Pump Tank: Gallons; PT Date

Nitrification Field: No Fields 1 Square Feet 720 Linear Feet 240

No Lines 3 Trench Width 36 Trench Depth 24 Gravel Depth 12

☑ New System ☐ Repair System Type: I, II, IV, V, VI

System Description: Conv. Gravity

Repair System Description:

Maintenance Agreement Required: ☐ Yes ☐ No

☐ House/Mod. Home ☑ Mobile Home ☐ Business ☐ Other

No. Bedrooms 2 No. Bathrooms 1 3/4 No. Employees

☐ Slab ☑ Crawl Space ☐ Basement w/plumbing ☐ Basement wo/plumbing

Garbage Disposal: ☐ Yes ☑ No


Auto. Dishwasher: ☐ Yes ☑ No

Auto. Washing Machine: ☑ Yes ☐ No


Other

Comments

INITIAL SITE SKETCH

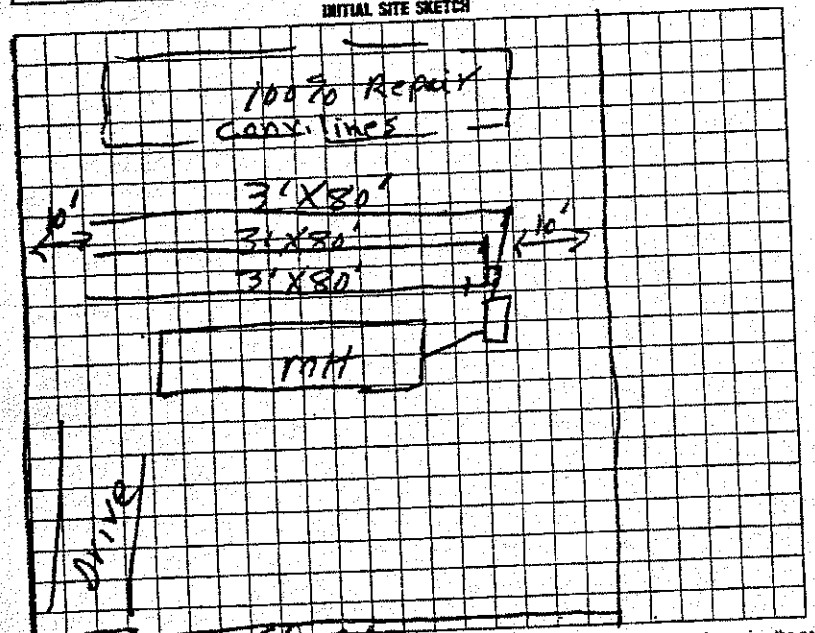

AS BUILT SKETCH

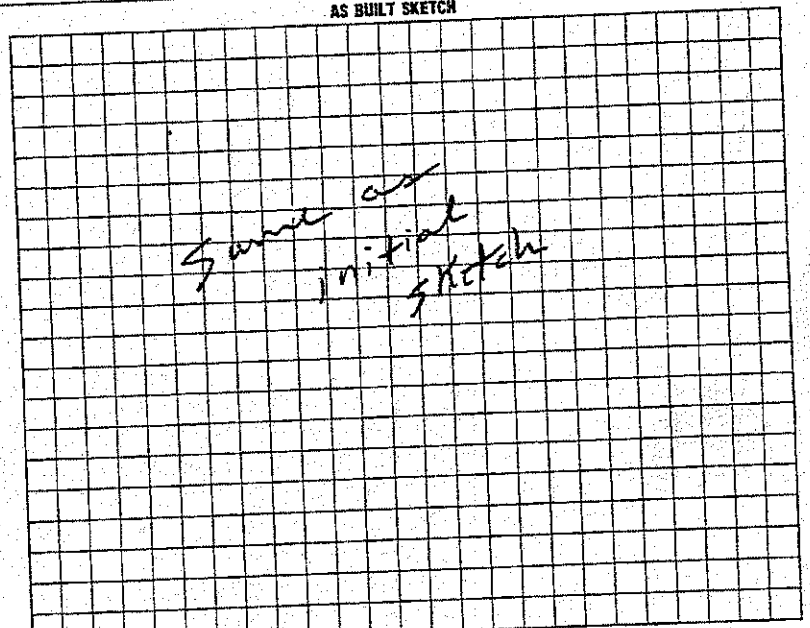

I understand that this permit can be suspended or revoked if any false information is supplied toward securing the permit/any unauthorized changes are made to the site/any unauthorized changes are made in the installation of the system. Improvement Permit is valid for 60 months from date of issuance.

Signed:

Improvement Permit by: E. C. Moore date 6-15-93

Existing System Inspection by: date

Installed by: A-1 Backhoe

Certificate of Completion by: E. C. Moore date 6-17-93

Operation Permit by: date

HEALTH DEPT. COPY: WHITE INSPECTION COPY (FINAL): GREEN OWNER COPY (FINAL): YELLOW INSPECTION COPY (INITIAL): PINK OWNER COPY (INITIAL): GOLD