IREDELL COUNTY HEALTH DEPARTMENT

STATESVILLE 704-878-5305 MOORESVILLE 704-664-5281

IMPROVEMENT PERMIT / AUTHORIZATION TO CONSTRUCT / OPERATION PERMIT / EXISTING SYSTEM INSPECTION

(2)

PERMIT# 122307 PIN# 4776-26-8149 DATE 7-8-04

OWNER OR CONTRACTOR COUNTRY LIVING HOME CENTER PHONE: Business 704-838-1429 Home

ADDRESS 590 MOCKSVILLE HWY, STATESVILLE NC 28677

LOCATION US 64 EAST, TL RIVER HILL ROAD, 1N 3.2 MILE ON LEFT

SUBDIVISION CLOVER DOWNS BLOCK / SECTION LOT 3 LOT AREA 1. ACRE SITE CLASS PS DESIGN FLOW 360 L.T.A.R. 0.30 GPD/FT²

Septic Tank: 1000 Gallons; STB 1012 Date 4-21-04

Pump Tank: Gallons; PT Date

Pump Make: Model Serial No.

Nitrification Field: No Fields 1 Square Feet EQ NO 1200 Linear Feet 300

No Lines FIVE Trench Width 36" Max Trench Bottom Depth 36" Gravel Depth N/A

☑ New System ☐ Repair System Type: I, II, III, IV, V, VI

System Description: 25% REDUCTION GRAVITY

Repair System Description: 50% REDUCTION, GRAVITY

Maintenance Agreement Required: ☐ Yes ☑ No

☐ House/Mod. Home ☑ Mobile Home ☐ Business ☐ Other

No. Bedrooms 3 No. Bathrooms 2 No. Employees


☐ Slab ☑ Crawl Space ☐ Basement w/plumbing ☐ Basement wo/plumbing

Water Supply: ☐ Individual ☑ Public ☐ Community


Comments:/Conditions: INSTALL 25% REDUCTION SYSTEM ON CONTOUR AS SHOWN. REMOVE EXISTING PARKING PAD IN VICINITY OF DRAWFIELD & REPAIR AREA

Comments:/Conditions: SEPTIC TANK WITH MARKER INSTALLED USING "TUFTITE" FILTER

INITIAL SITE SKETCH

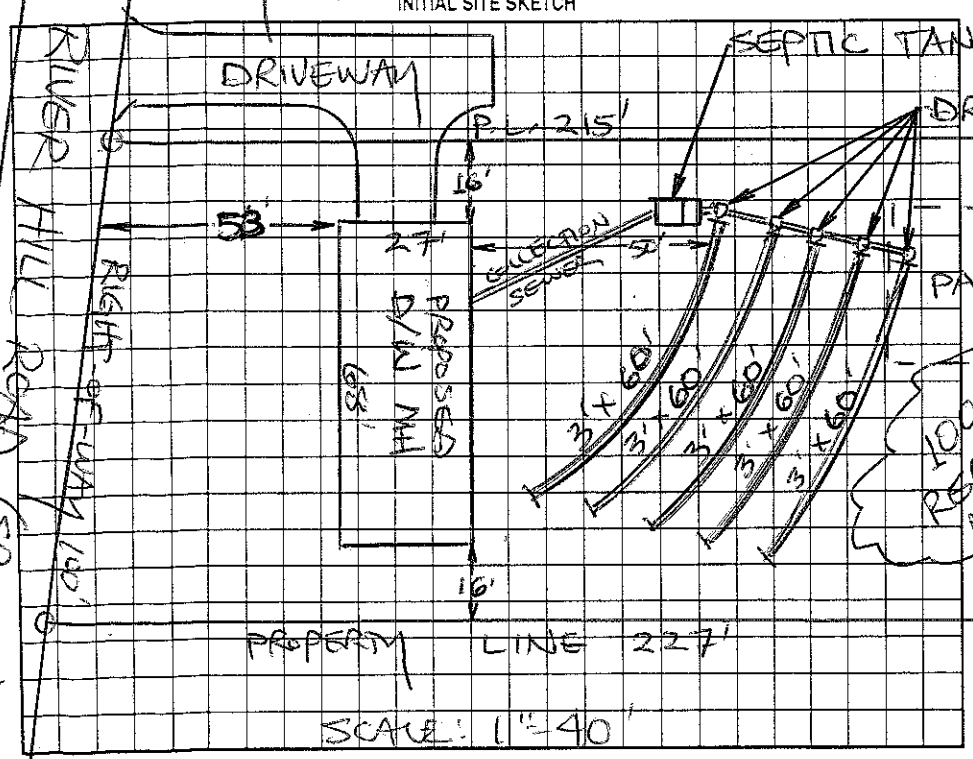

AS BUILT SKETCH

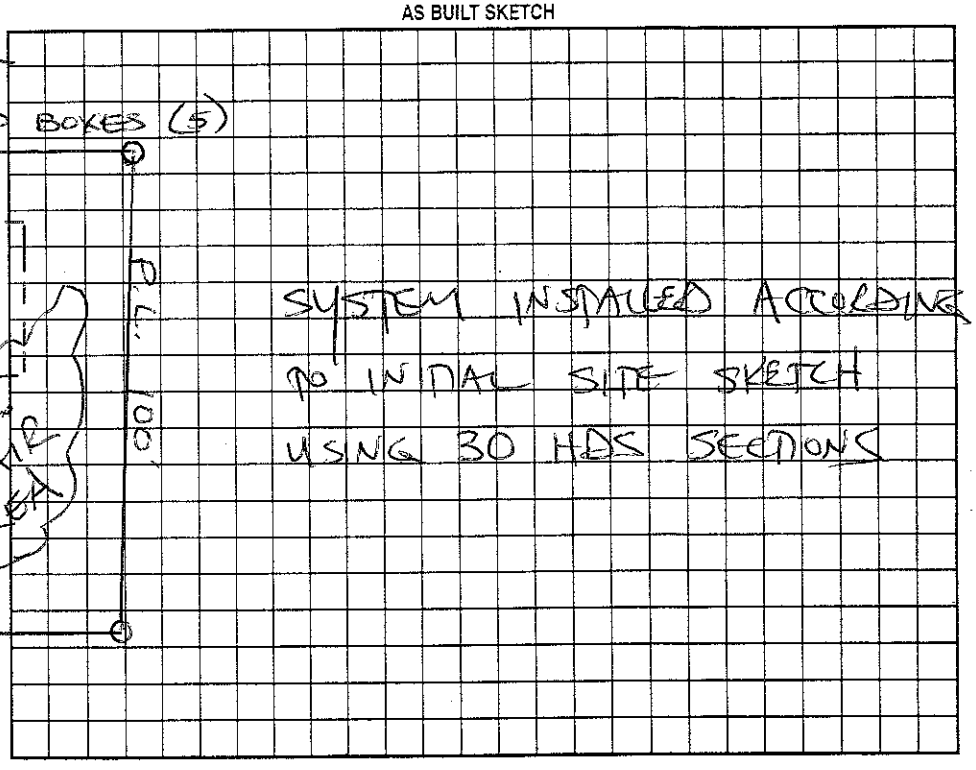

Permit can be suspended or revoked if any false information is supplied toward securing the permit/any unauthorized changes are made to the site/any unauthorized changes are made in the installation of the system. Improvement Permit with plat valid without expiration. Improvement Permit with site plan valid for sixty months. Authorization to Construct is valid for a period equal to that of Improvement Permit – not to exceed sixty months.

Signed: date 7-8-04

Improvement Permit by: STEVE HEDRICK date 7-8-04

Authorization to Construct by: STEVE HEDRICK date 7-8-04

Installed by: C & S GRADING

Operation Permit by: STEVE HEDRICK date 8-27-04

Existing System Inspection by: date

HEALTH DEPT. COPY: WHITE OWNER COPY (FINAL): YELLOW OWNER COPY (INITIAL): PINK