IREDELL COUNTY HEALTH DEPARTMENT

STATESVILLE 704-878-5305 MOORESVILLE 704-664-5281

IMPROVEMENT PERMIT / AUTHORIZATION TO CONSTRUCT / OPERATION PERMIT / EXISTING SYSTEM INSPECTION

PERMIT # 155915 PIN # 4776269021 DATE 5-7-09

OWNER or APPLICANT Belinda Gaither PHONE: Business Home: 704-402-7658

OWNER or APPLICANT ADDRESS 924 Riverhill RD Statesville NC 28625

LOCATION / DIRECTIONS 64E (R) River Hill 1/2 mile past East Middle School on right

SUBDIVISION Clover Downes BLOCK / SECTION LOT # 21 LOT AREA .575 DESIGN FLOW 360 L.T.A.R. .3

Septic Tank WNW	Gallons: STB 750	Date 8-7-09	☑ New System ☐ Repair ☐ Expansion System Type I II III IV V VI
Pump Tank	Gallons: PT	Date	System Description: 25% Gravity
Pump Make	Model	Serial #	Repair System Description: 50% low pres.
Nitrification Field No Fields ___ No Lines ___	Linear Feet 300		Maintenance Agreement Required ☐ YES ☐ NO
Trench Width	Max. Trench Bottom Depth 36"	Gravel Depth NA	☑ GRAVITY ☐ PRESSURE

☑ Residence No. Bedrooms 3
☐ Business No. Persons
☐ Other No. Employees
☐ Slab ☐ Crawl Space
☐ Basement w/plumbing ☐ Basement w/o plumbing

Water Supply: ☐ Private ☑ Public ☐ Community


Comments / Conditions

Mobile home must be 15' off property line

Comments / Conditions

Install on contour
Maintain all setbacks

INITIAL SITE SKETCH

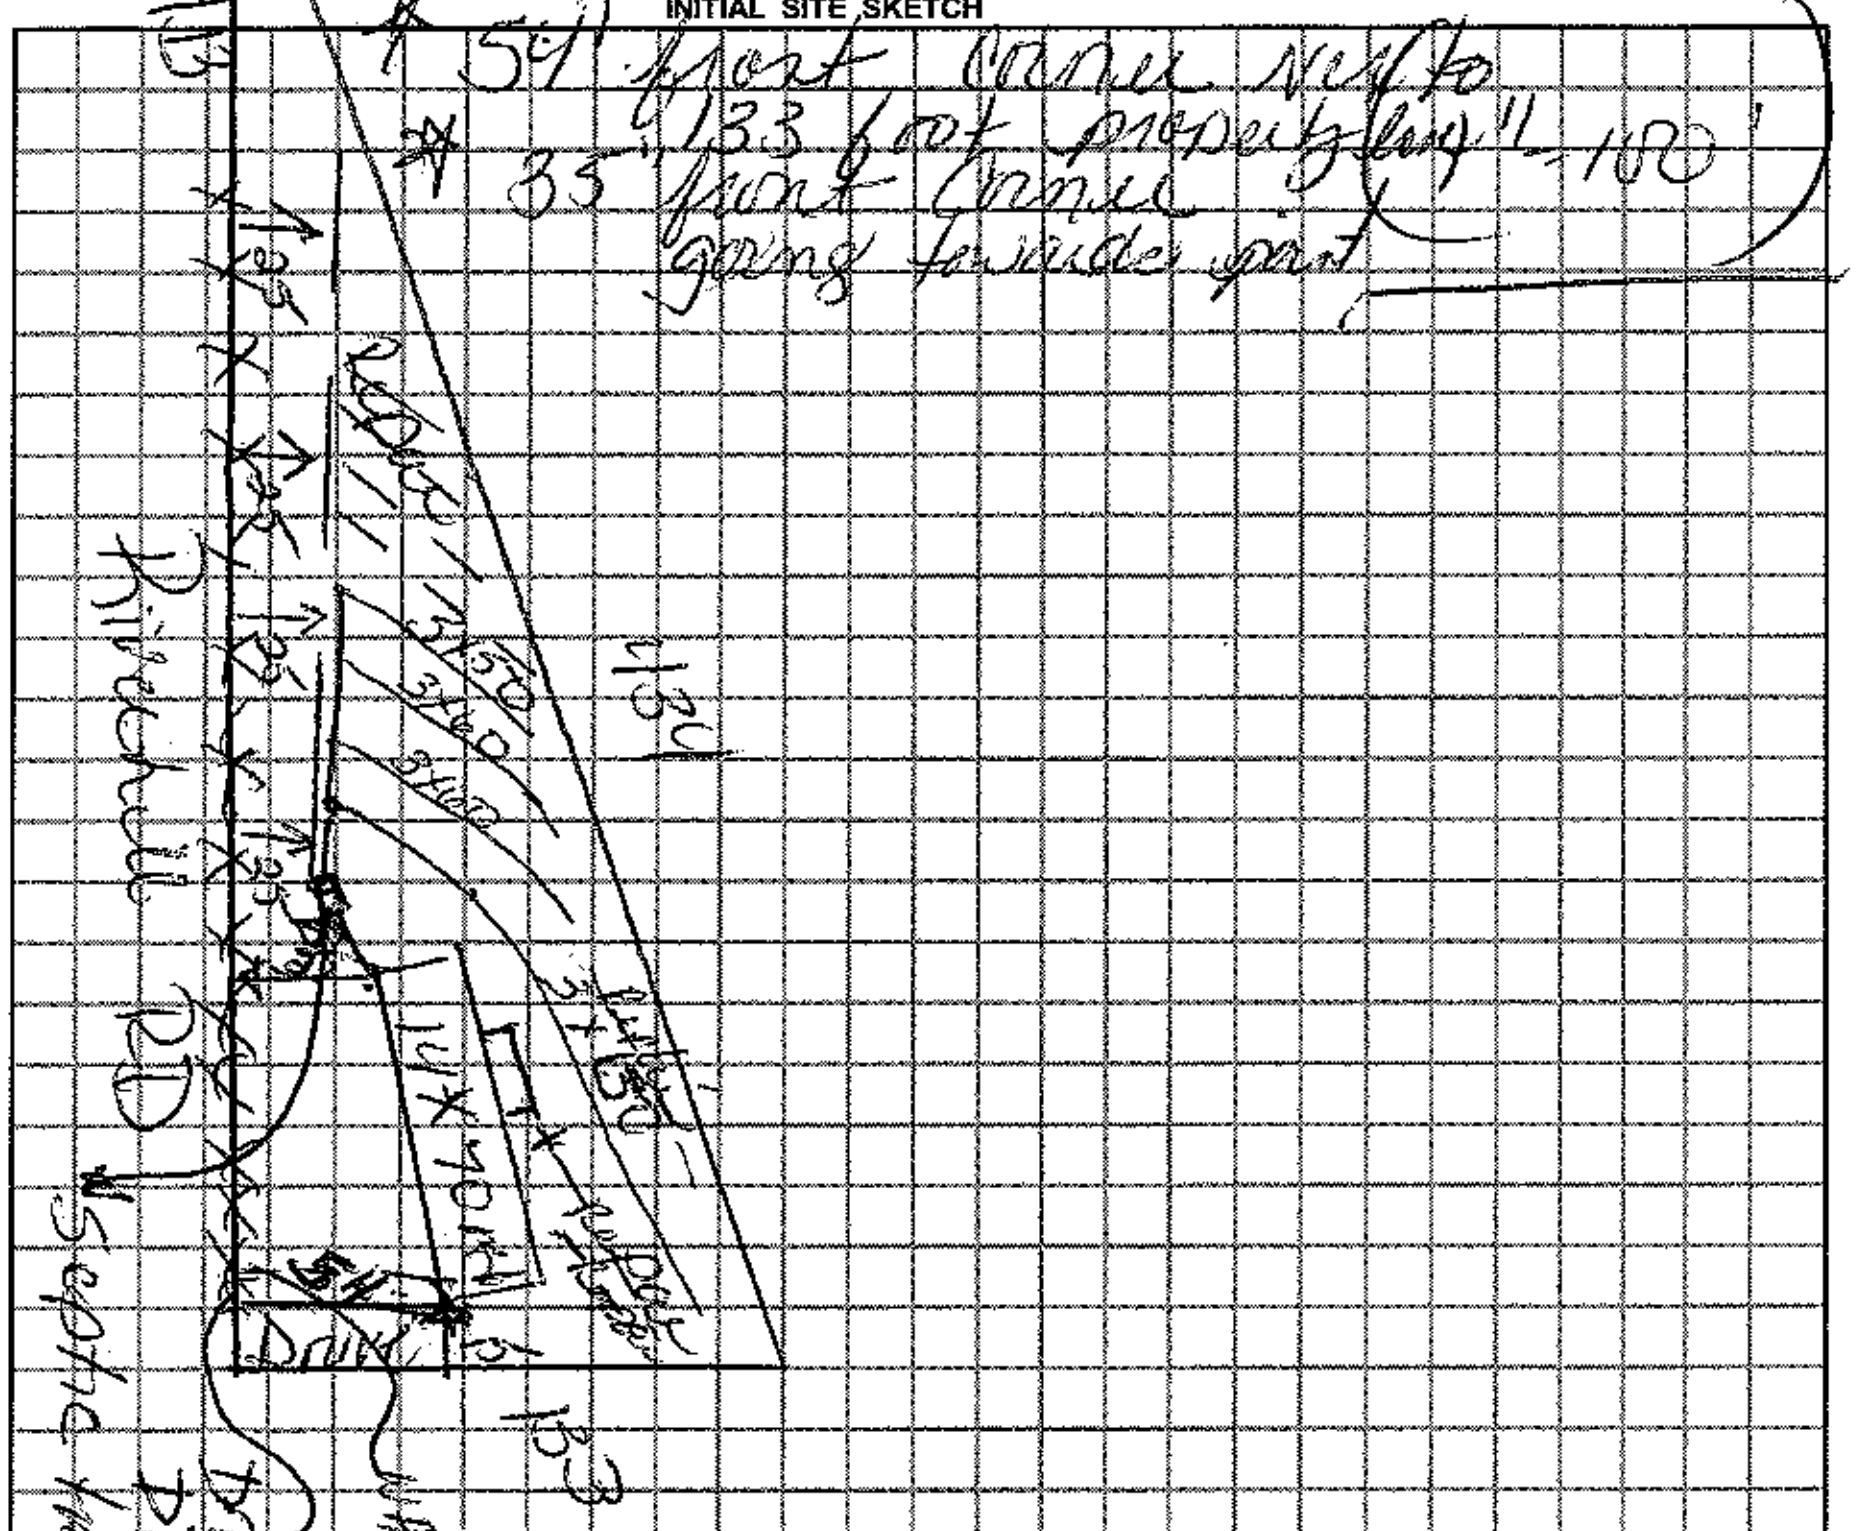

AS BUILT SKETCH

* Rake side walls

BD difuser
ARC 34

Red Leaf Tile
Septic Maker

Permit can be suspended or revoked if any false information is supplied toward securing the permit / any unauthorized changes are made to the site / any unauthorized changes are made in the installation of the system.

☐ *IMPROVEMENT PERMIT w / plat valid without expiration.* ☑ *IMPROVEMENT PERMIT w / site plan valid for 60 mos.* ☑ *AUTHORIZATION TO CONSTRUCT valid for period equal to IMPROVEMENT PERMIT-not to exceed 60 mo.*

Owner / Applicant Signature: Belinda Gaither Date 5-7-09

Improvement Permit by: Kerry Cook Date 5-7-09

Authorzation to Construct by: Kerry Cook Date 5-7-09

Installed by: Abel Gardner

Operation Permit by: Kerry Cook Date: 1-27-10

Existing System Inspected by: Date:

YOU SHOULD CONTACT A LOCATOR SERVICE PRIOR TO ANY EXCAVATION.

WHITE COPY Environmental Health YELLOW COPY (Final) Owner / Applicant PINK COPY (Initial) Owner / Applicant