4:00

IREDELL COUNTY HEALTH DEPARTMENT

STATESVILLE 704-878-5305 MOORESVILLE 704-664-5281

IMPROVEMENT PERMIT / CERTIFICATE OF COMPLETION / OPERATION PERMIT / EXISTING SYSTEM INSPECTION

PROPERTY DESCRIPTION NO. 26100 DATE 2-3-97 TAX MAP NO. 4776-26-9315 Watershed: ☐ Yes ☐ No

OWNER OR CONTRACTOR Marcelino D. Jacinto PHONE: Business 873-1014 Home

ADDRESS 2130 W. memorial Hwy Union Grove

LOCATION US 64 E TL Rivershill Rd past Dairy Ln 1/4 mi left

SUBDIVISION Clover Downs BLOCK / SECTION LOT 4 LOT AREA 54,020 SF SITE CLASS. 5 DESIGN FLOW 360 L.T.A.R. 3

Septic Tank: 1000 Gallons: STB 620 Date 2-12-97

Pump Tank: Gallons: PT Date

Pump Make: Model Serial No.

Nitrification Field: No Fields 4 Square Feet 1200 Linear Feet 400

No Lines 4 Trench Width 36" Max Trench Bottom Depth 36" Gravel Depth 12"

☑ New System ☐ Repair System Type: I, II, III, IV, V, VI

System Description: Conv Gravity

Repair System Description: " "

Maintenance Agreement Required: ☐ Yes ☐ No

☐ House/Mod. Home ☑ Mobile Home ☐ Business ☐ Other

No. Bedrooms 3 No. Bathrooms 2 No. Employees


☐ Slab ☑ Crawl Space ☐ Basement w/plumbing ☐ Basement w/o plumbing

Water Supply: ☐ Individual ☐ Community ☑ Public

Comments:


226'

INITIAL SITE SKETCH

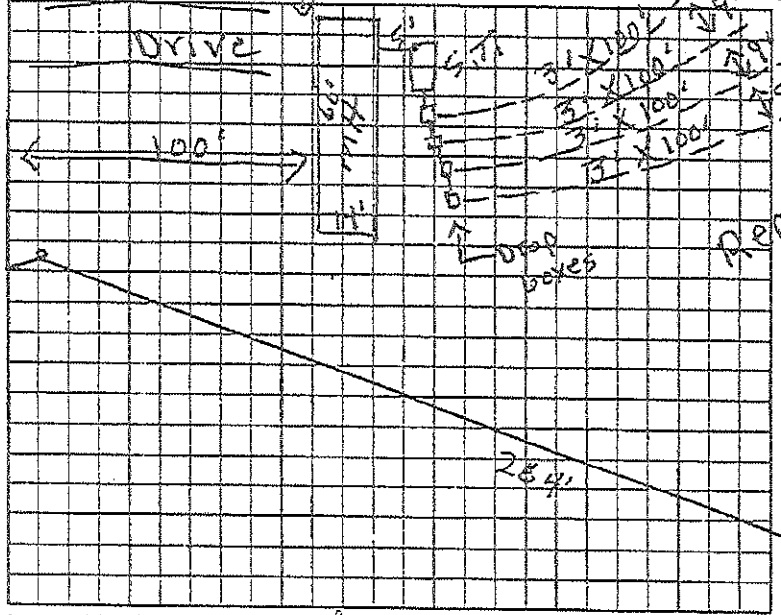

Comments:

AS BUILT SKETCH

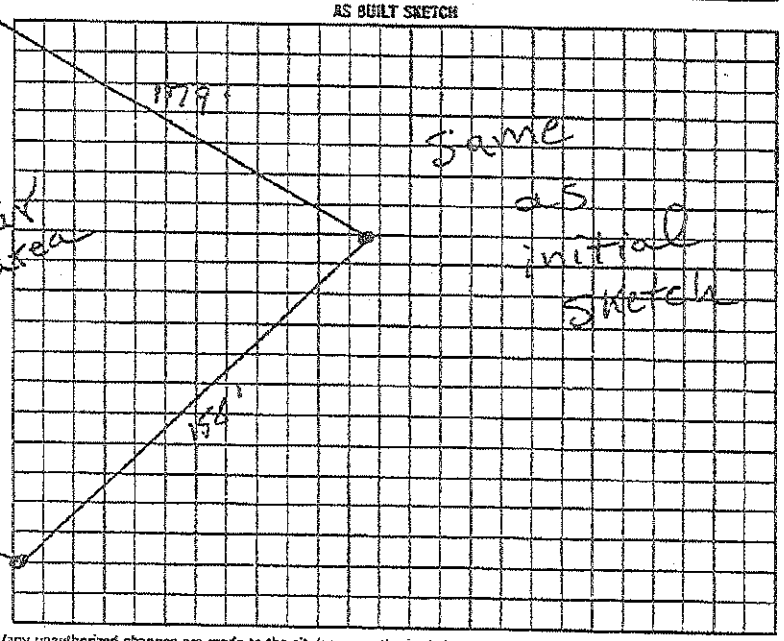

I understand that this permit can be suspended or revoked if any false information is supplied toward securing the permit/any unauthorized changes are made to the site/any unauthorized changes are made in the installation of the system. Improvement Permit is valid for 60 months from date of issuance.

Signed: [signature]

Improvement Permit by: P.C. Moore date 2-3-97

Authorization to Construct by: P.C. Moore date 2-3-97

to construct DEPT. COPY WHITE INSPECTION COPY (FINAL) GREEN OWNER COPY (FINAL) YELLOW

Installed by: Sammy Reavis

Certificate of Completion by: date

Operation Permit by: P.C. Moore date 3-13-97

authorization to const. Expires 60 mos from issue

INSPECTION COPY (INITIAL) PINK OWNER COPY (INITIAL) GOLD

9 2 6 0 0 0